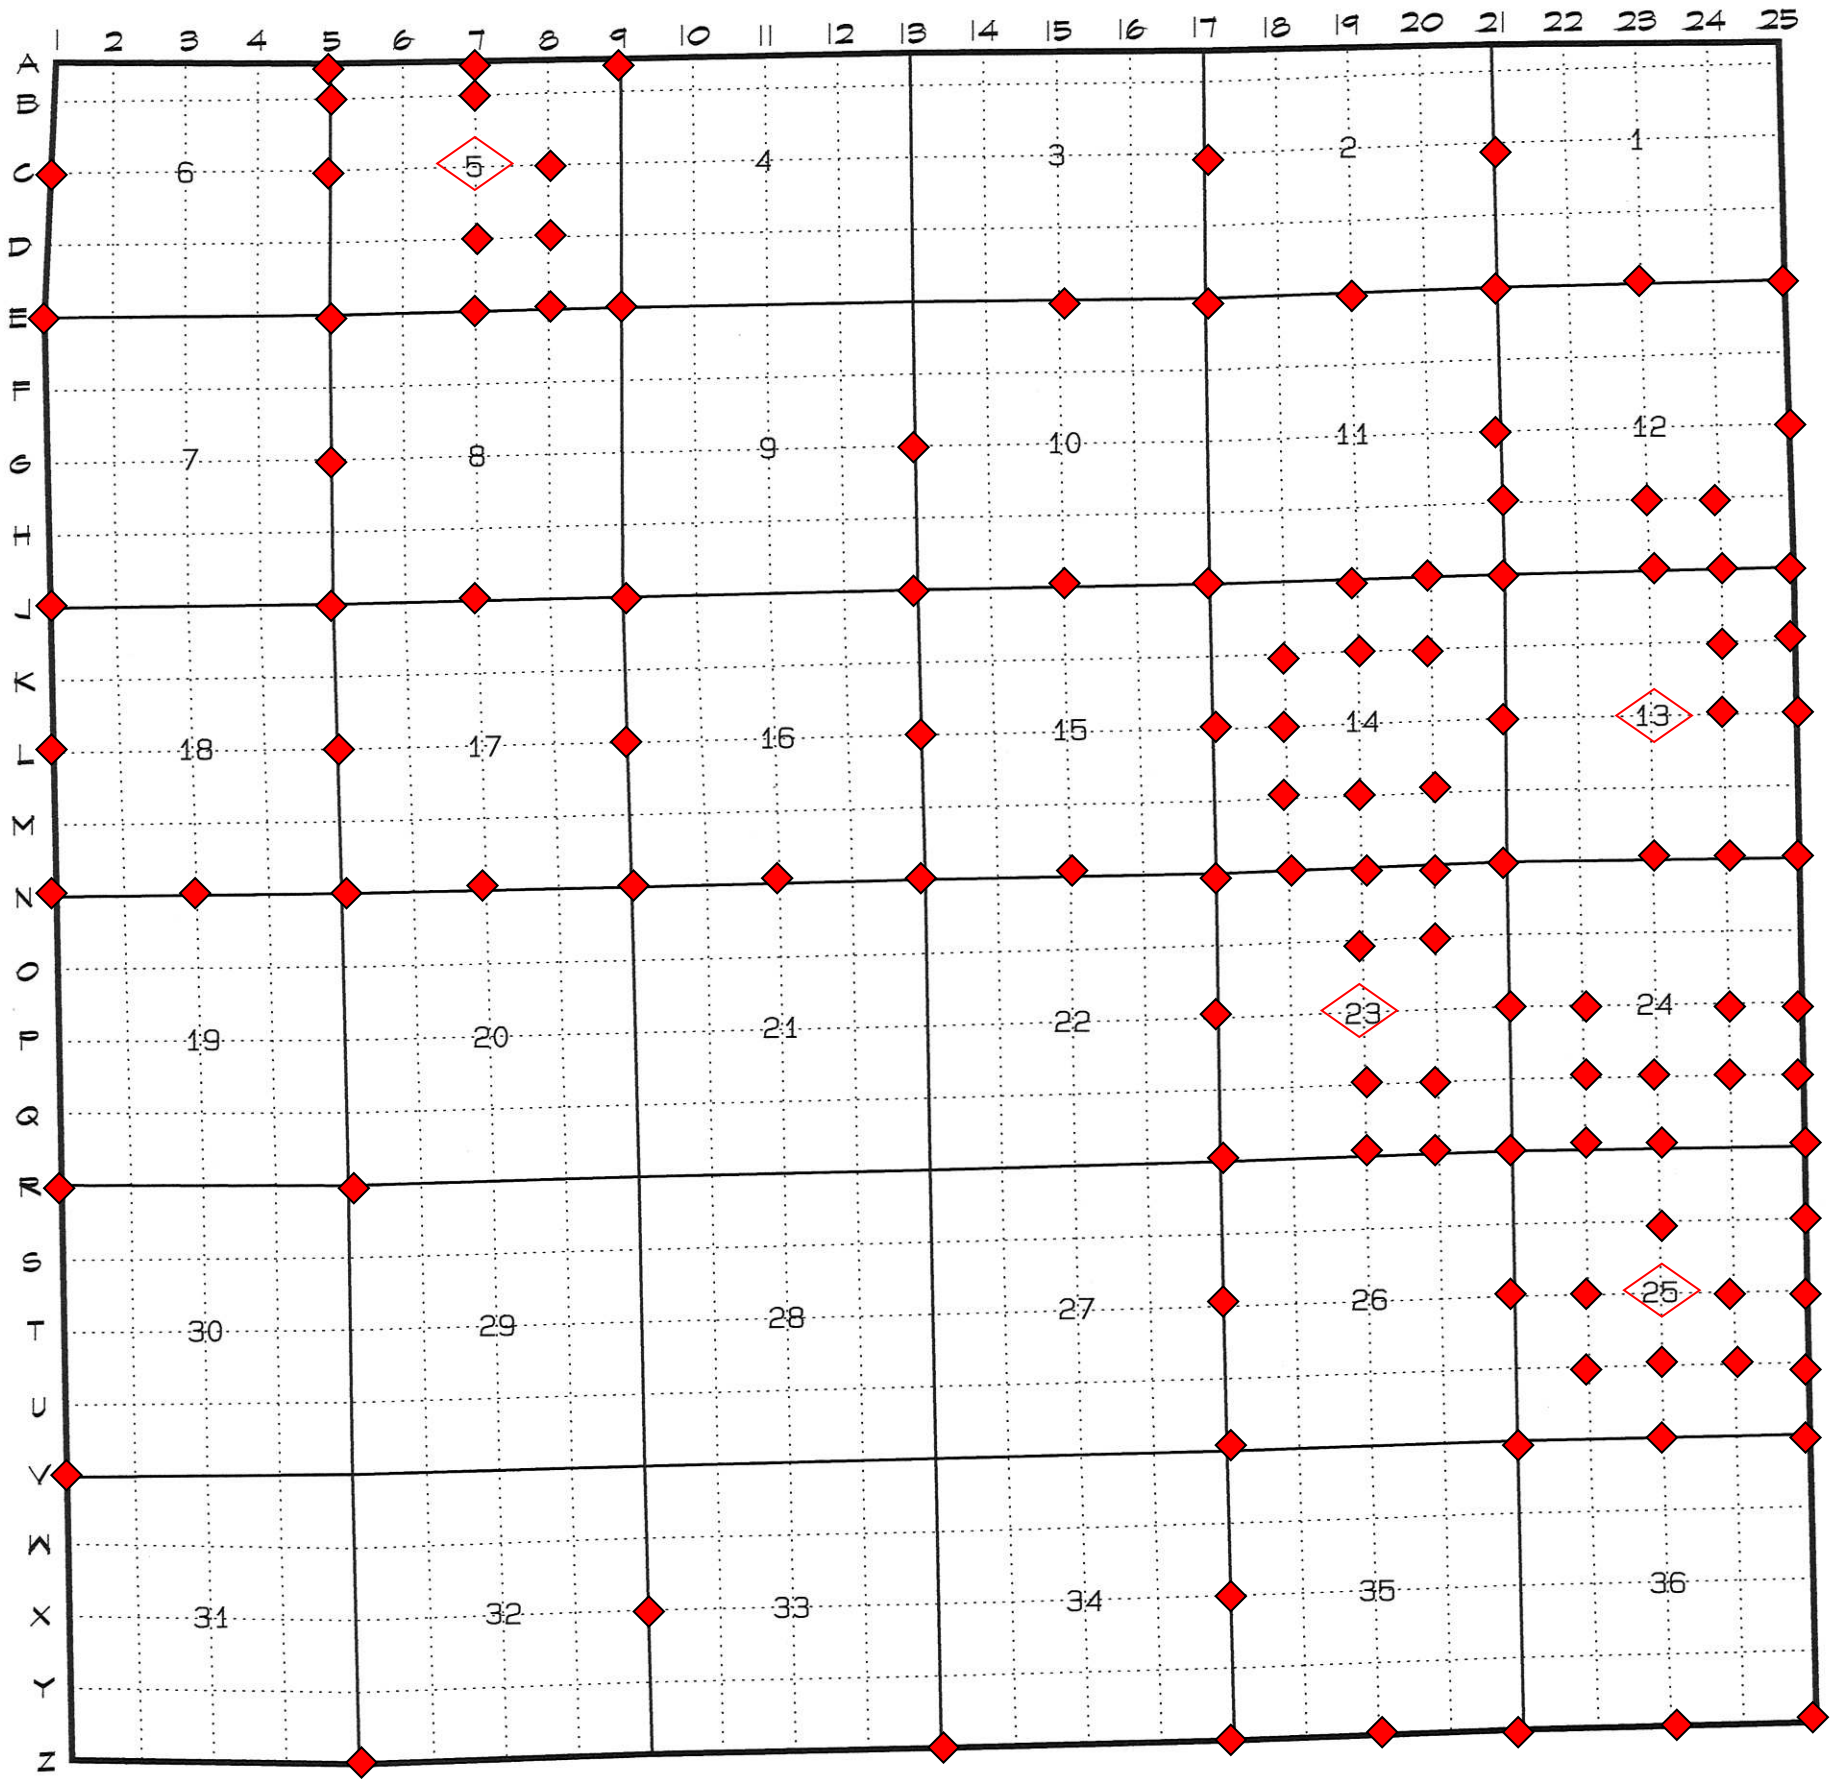TOWNSHIP 4 SOUTH RANGE 30 EAST