


Thence	N		2.23	A.
"	E	18	9.85	To Pine Street Alba
"	"	"	27.55	" Penoyer " "
"	N		30.70	" Wager " "
"	E		35.18	To Broad " "

I hereby certify that the foregoing are the field notes of road survey N^o 297 as made by myself Aug 2nd 45th 1887
 La. F. Knight, Surveyor
 Alba Umatilla Co. Or, Aug 10th 1887.

Plat of Road N^o 297

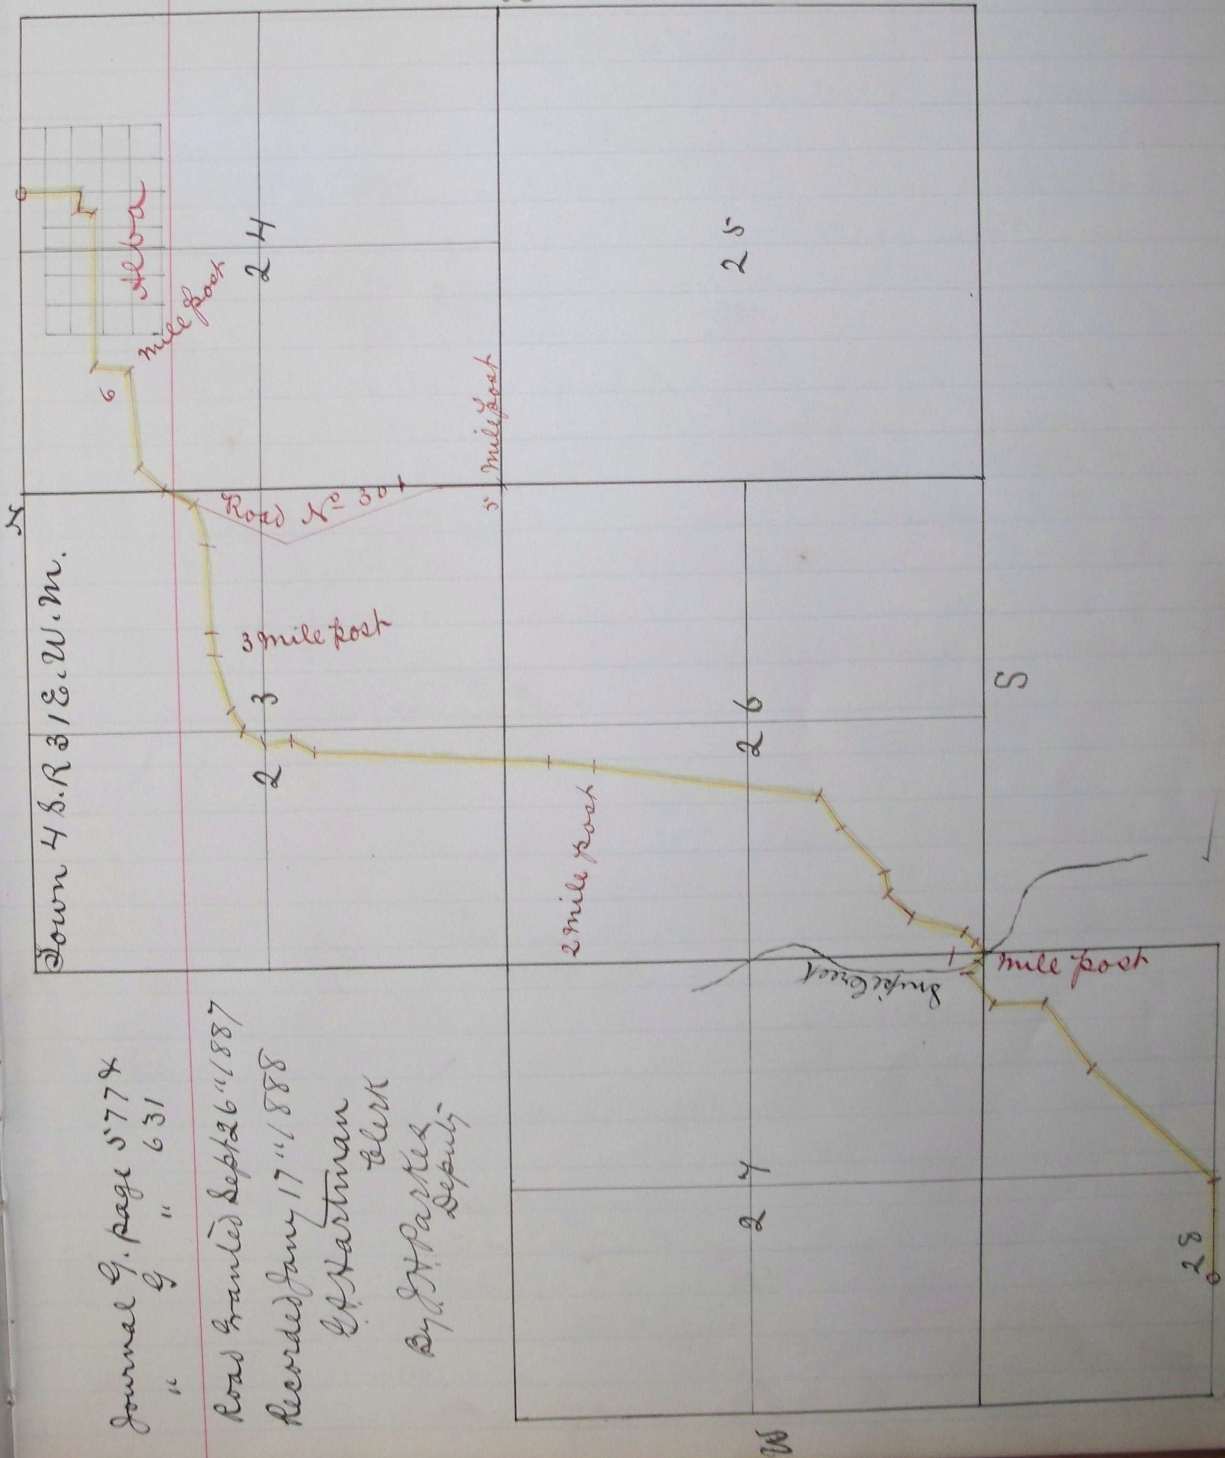

Journal G. page 5774
 " " 631
 Road granted Sept 26th 1887
 Recorded Jan 17th 1888
 L. Hartman Clerk
 By J. H. Partles Deputy

m B. W.
 Road N^o 301

