


Plat of Road No 299  
for Umatilla Co. Or.

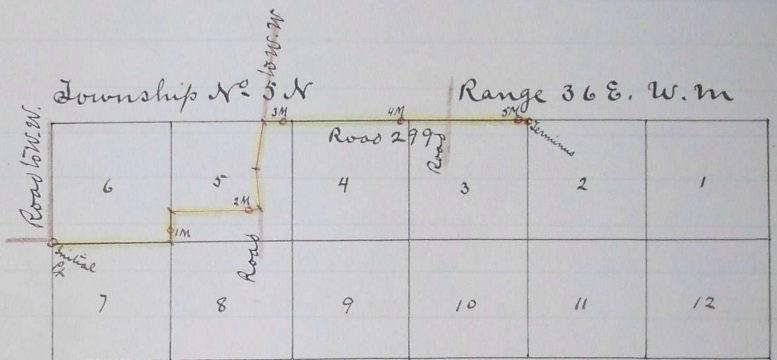

I hereby certify the foregoing to be a  
correct plat of County road No 299.  
Jno. C. Arnold,  
Surv.

Journal G. page 582  
" " " 630  
Road Granted Sept 26 1887  
Recorded Jan 18 1888  
L. A. Hartman  
Clerk  
By J. H. Parker  
deputy