
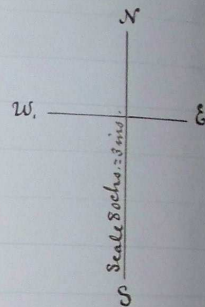


Plat of Road No 303.

T 4 N. R 35 E W 1/4

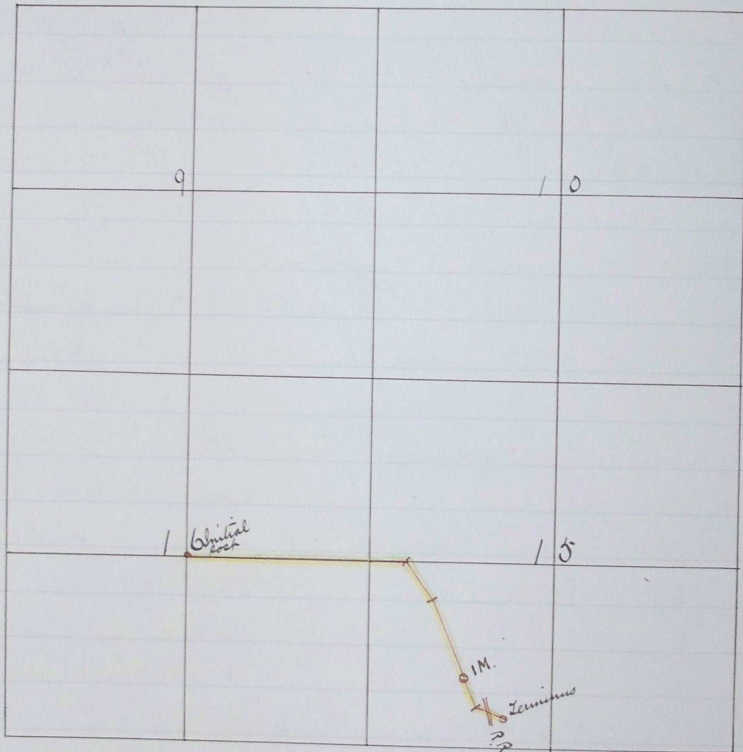

I hereby certify the following to be a correct plat of road survey 303, Township 4 N. Range 35, East of Willamette meridian, as made by me, November 15th 1887

Jno E. Arnold
Surveyor for Umatilla
County, Oregon.

Journal 9. page 626

" 9 " 707

Road Granted Jan'y 9th 1888

Recorded Jan'y 19th 1888

G. A. Hartman

Clerk

By J. H. Parkes

Deputy