
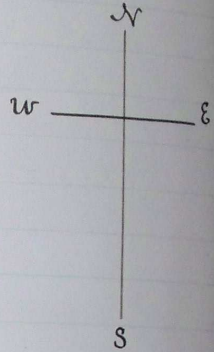


Plat of Road No 302.

I hereby certify the following to be a correct plat of the survey of road 302, Townships 5 & 6 N. Range 3 S. East of Willamette meridian, as made by me, Nov 16, 17 & 18 1887.

Jno C. Arnold  
Surveyor of Umatilla County, Oregon

5x67 35 E

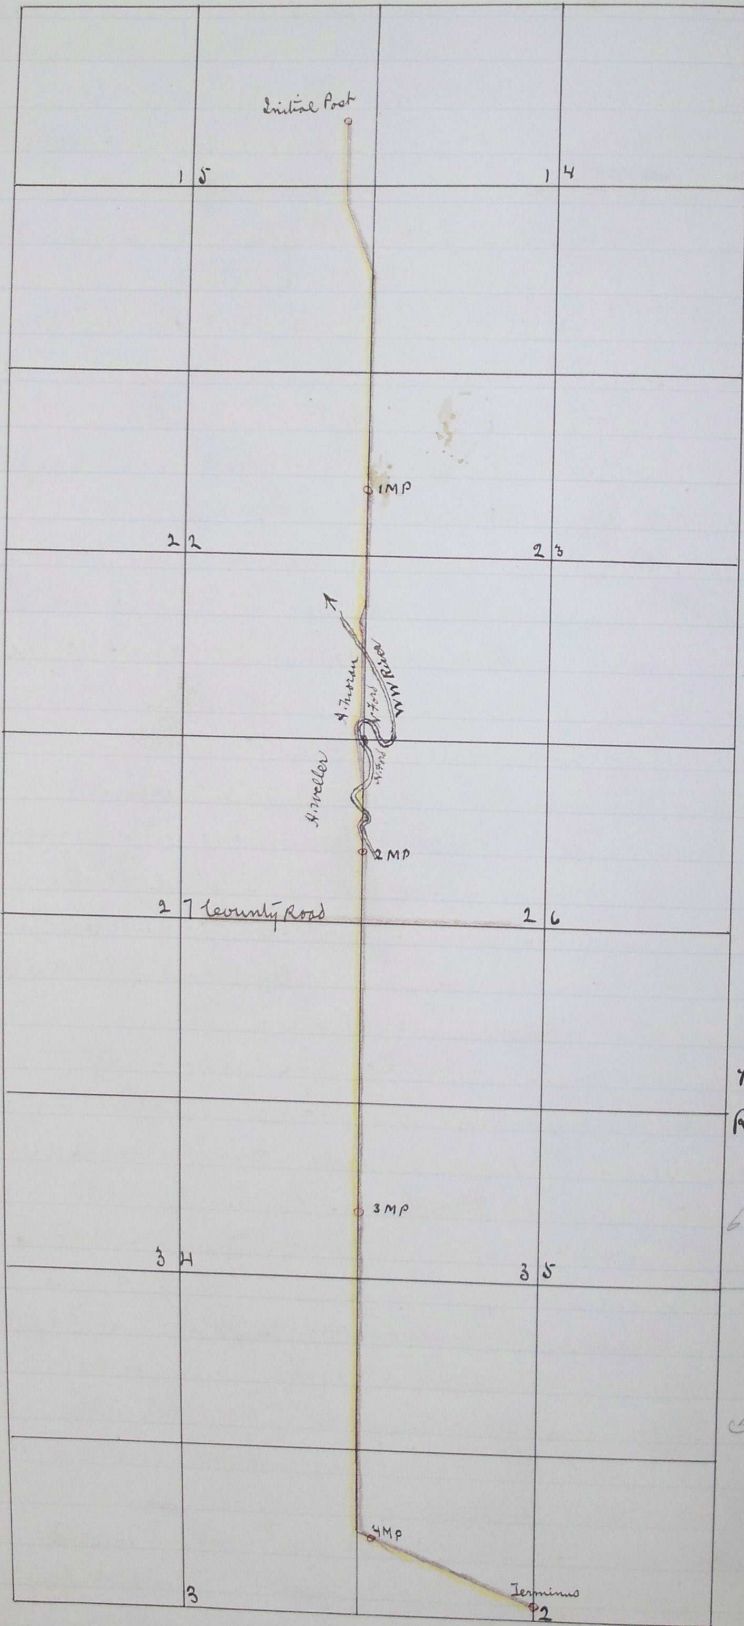

Book 9. page 621  
 " 9. " 706  
 " H " 14  
 Road Granted April 12/88  
 Recorded April 18 1888  
 G. A. Hartman  
 Clerk  
 By J. H. Parkes, Deputy

57

ROAD NO  
306.

No. 3  
 200.0  
 160.0  
 80.0  
 See.