


S 88° 30' W 5.00 Summit; descend
 21.50 Ravine runs S.W.; ascend
 37.92 Cor. for Sec. 18 & 19 on line bet. Ranges 32 & 33 E. Fences run N. & S
 & W. from Pt.; Summit. I turn 90° R. along Rangeline, by reputation
 N 1° 30' W 77.33 Intersect County Road at angle in lane N & W. S.W. cor of N. W. 1/4 of
 Sec. 18 T. 4 N. R 33 E. I set sawed for post 4x4 ins. 4 ft long mark-
 ed R on South face in earth mound 4 ft. sq. at base and 2 ft.
 high 30 links east of Pt.

I hereby certify the foregoing notes of Road Survey no 310 for
 Umatilla Co., Or., are correct.

Jno C. Arnold, Co. Surveyor.

Plat of Road Survey no 310

Township 4 N Range 33 E. W. M.

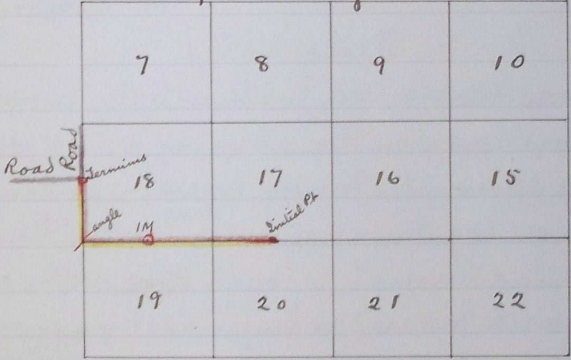

I hereby certify the foregoing plat of Road
 Survey no. 310 for Umatilla Co. Oregon is
 correct.

Jno C. Arnold, County Surveyor

Journal N. page 54
 " N. " 95
 Road Granted July 11 " 1888
 Recorded Oct 11 " 1888
 S. A. Hartman
 County Clerk

By J. H. Parker, Deputy

ntly Road
 to see cor
 said see
 etfully
 Arnold
 in our
 on com-
 and much
 a public
 be granted,
 Umatilla
 lace ap-
 of E. M.
 Admin-
 ce, and
 bet. Secs.
 porting
 20' E
 20'
 rting to
 20'
 30'
 with face
 on south
 W. 1/2 of