

- 80.00 Set 1 mile post, 30 links N. of pt. on E. hill side in field.
- 5.30  $\frac{1}{4}$  S. Co. bet. Secs. 22 & 27.
- 16.00 Summit. Descend.
- 20.75 Ravine - 8'; runs N.W.; Ascend
- 26.00 Summit. Descend.
- 27.50 Ravine runs N.; Ascend
- 31.00 Summit.
- 38.00 Abrupt descent. - 40'
- 40.00 Center of hollow, course N.E.
- 40.50 Ascend hill.
- 44.00 Summit of steeper part; ascend gently.
- 70.00 Main Summit. Descend gently
- 80.00 Set 2 mile post, 30 links South of pt. in wheat field.
- 10.50 Ravine - 10', runs S.W.; Ascend
- 25.00 Summit; Descend.
- 30.00 Ravine - 15', runs S.W.; Ascend
- 35.00 Summit, Descend
- 40.50 Ravine - 6', nearly South; Ascend.
- 42.70 Int. road in lane N.E.S. at Saylor Paris' Res. Set terminus at pt.


I hereby certify that the foregoing notes of road survey No. 320 for Umatilla Co. Or. are correct.

Jno. C. Arnold, Surveyor.

I hereby certify that the following is a correct plat of Road Survey 320, for Umatilla County, Oregon.

Jno. C. Arnold, Surveyor.

Township 5 N. Range 34 E. W. M.

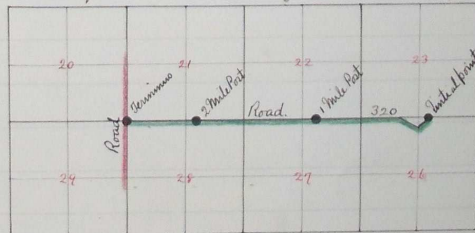

Filed April 1<sup>st</sup> 1889  
G.A. Hartman, Clerk