

ROAD No
346.

Road No 346

Report of viewers, field notes and plat of survey of County Road No 346 in Umatilla County, Oregon; commencing at the E.W. corner of the S.E. 1/4 of the E.W. 1/4 of Sec 18 T4 ER. 37 E. thence South 80 rods, thence East 80 rods to the center of said Sec 18, thence South one and one half miles, thence East one half mile to the corners of Sections 19-20-29-30, thence South 40 rods thence in an Easterly direction till it intersects said Basket Mtg road and also to vacate the road from where this road leaves to where it intersects before mentioned Basket Mt road. said road to be 60 feet wide

Report of Viewers

To the Honorable County Court of the State of Oregon, for Umatilla County

We the undersigned, the viewers heretofore appointed to view and locate Road No 346 submit the following report: Pursuant to an order of the Honorable Court we met Jno C. Arnold Surveyor at Thomas Lerrardo house on August 11th 1890 and were by him, each, duly sworn to faithfully and impartially discharge the duties of our appointments.


We called to our aid Edgar Thomson } Chairman
Wiram Milliken }
Thomas Lerrard } Marker
Jas Lumbos }
Jacob Demaris } Assn

who were by the Surveyor, each duly sworn, like viewed, surveyed and located said Road No 346 Three hundred and forty six as specified in our order

We find the route quite practical and much shorter than the road now being traveled between the points of the beginning and ending of the present survey.

The greatest work necessary to open this Road will be the cutting away brush and timber along the line E. + S. through the center of Sec 19 in T4 N R 37 E

We would therefore recommend that Road No 346

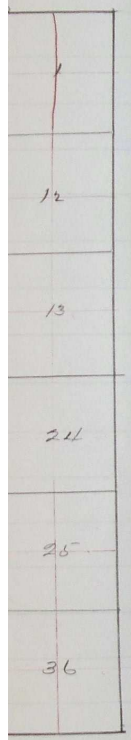

rect
Co. Dr.
S
Surveyor