


Plat of R. 370

2/6 27th R. 32 E.

2/6 17th R. 32 E.

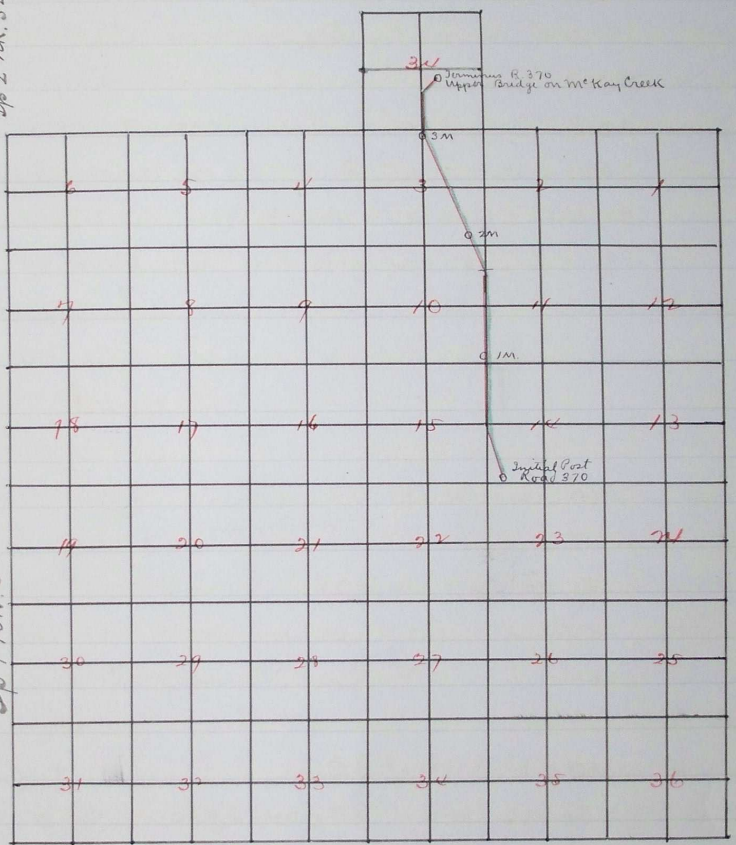

I hereby certify that the foregoing is an accurate plat of Road Survey No 370.

Jno. C. Arnold
Co Surv.

Filed Sept. 8th 1891,
W. M. Pierce Clerk

H 763