


Plot of Road Survey 371
Scale 5280' = 1"

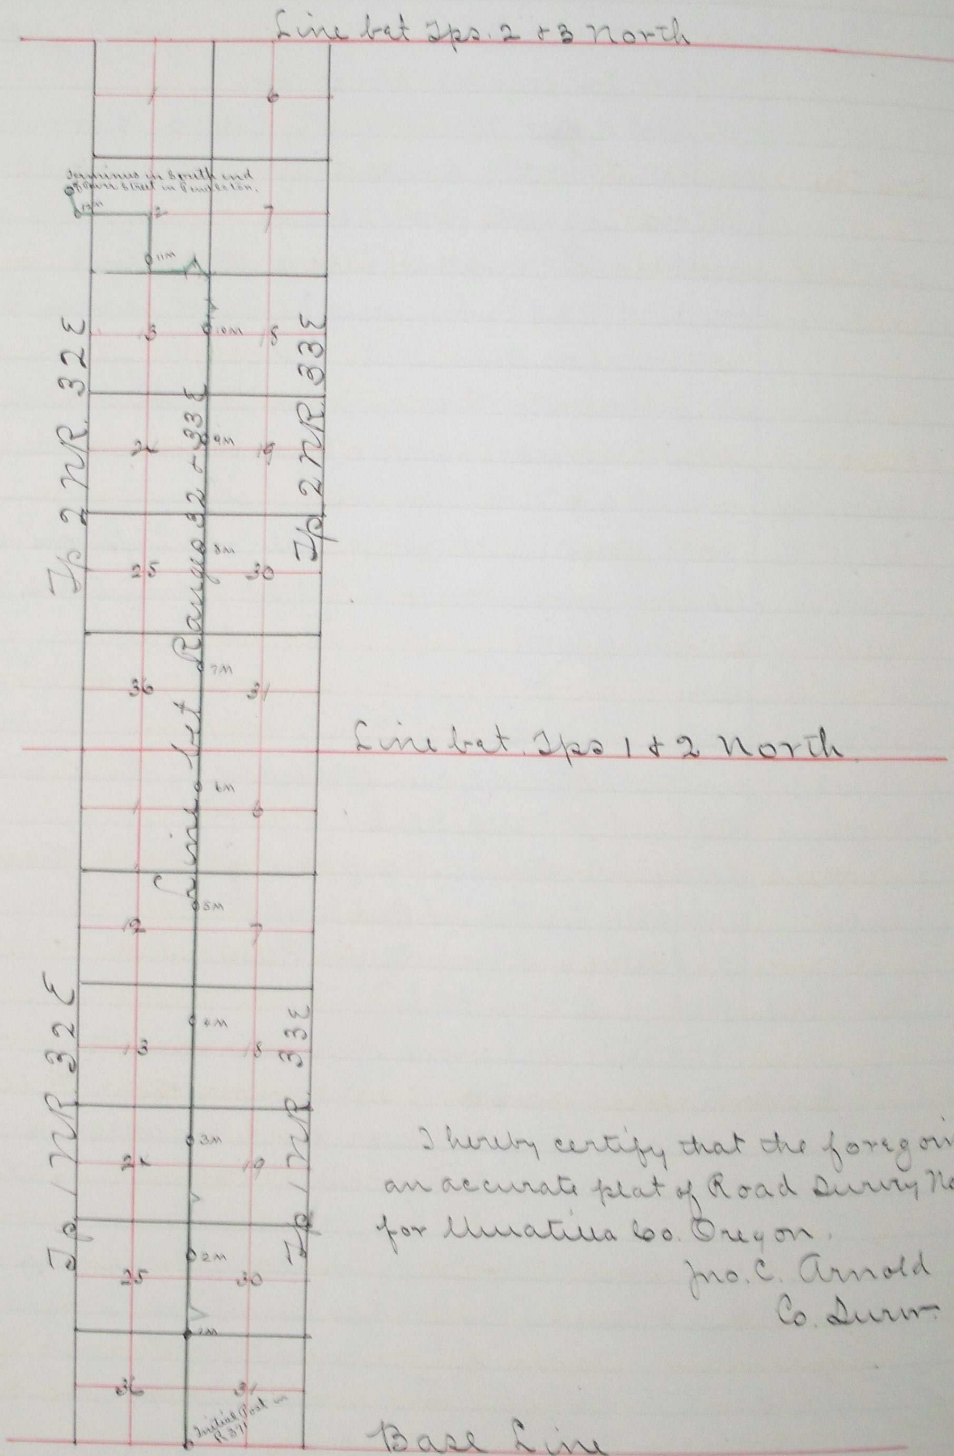

I hereby certify that the foregoing is
an accurate plat of Road Survey No 371
Jno. C. Arnold
Co. Surveyor

Base Line

Filed Sept 5' 1891
W. M. Bice Clerk.

H 775

ROAD No
373.

Re
No
4
by
p
M
9
6
5
6
T
2
6
5
2
t
W
w
W
as
W
as
in
for
the
a
de
a
E
W