ROAD No 374.

Plat of Survey Road No 373

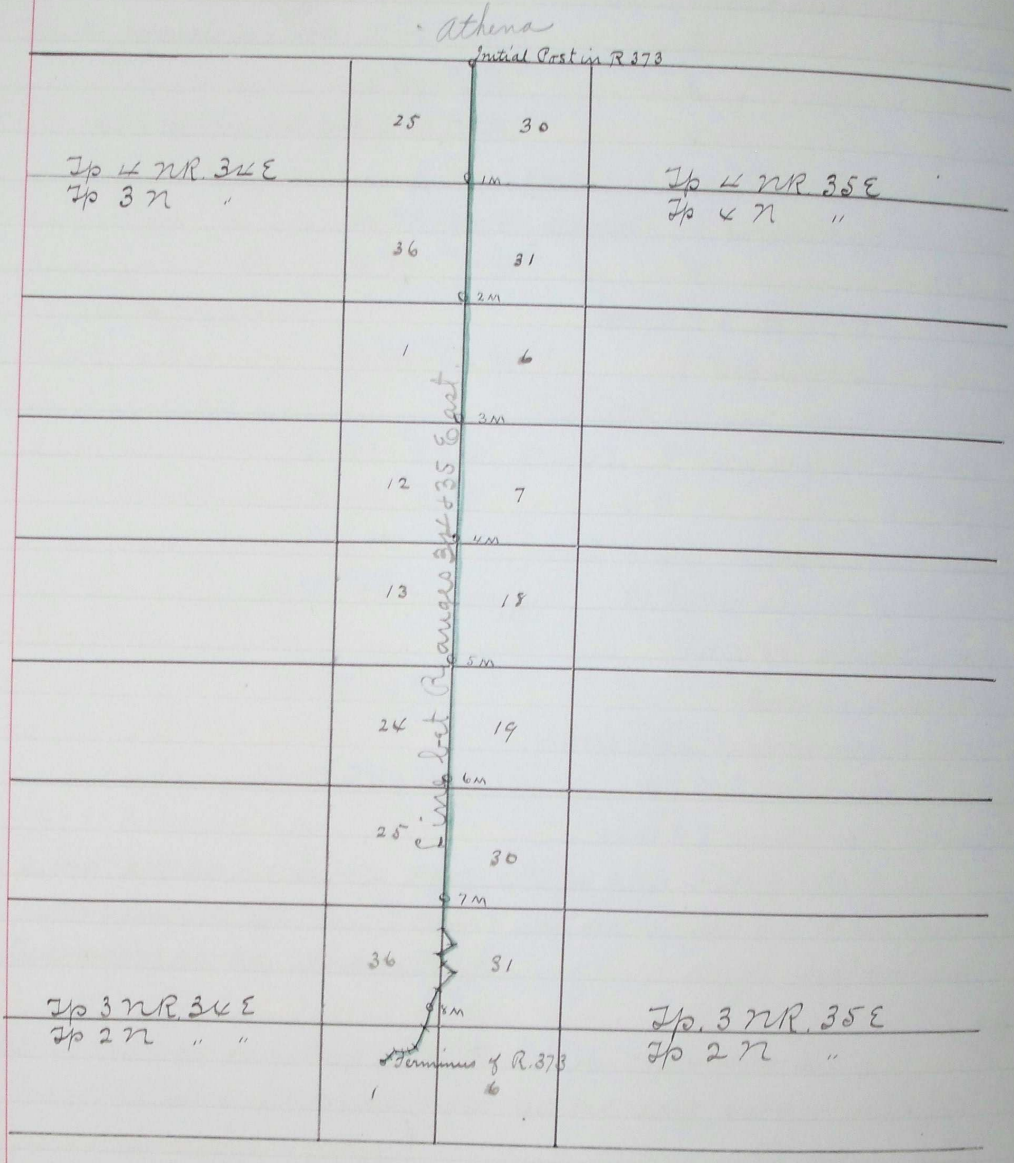

Scale 1 inch to one mile.

I hereby certify that the above is an accurate plat of said Road.

Jno. C. Arnold
Co. Surv.

Filed Sept. 8th 1891
W. M. Bird Clerk.

H 772

Filed Oct. 29 1891
W. M. Bird Clerk