


Oct. 17 1891.
W.C. Betts,
Min. Pro.

tree to the
of the cor,
and on
roots of
E

Plat of Road Survey No. 377.

Township 1 South Range 35 East

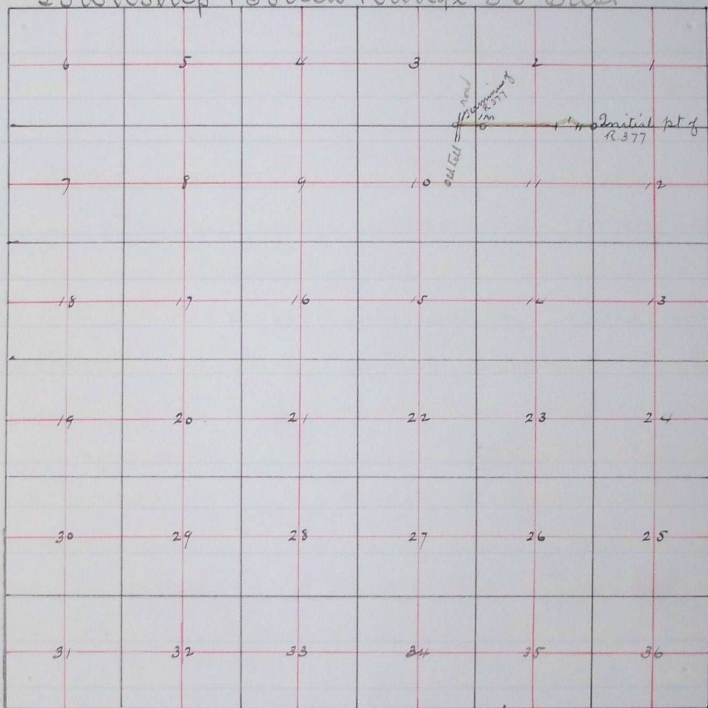

I hereby certify that the foregoing is a correct plat of Road Survey No 377, for Umatilla County, Oregon.

Jno. C. Arnold
Co. Surveyor.

Filed Nov. 2 1891
W.M. Pierce Clerk
J.E. Beam Deputy

120

5'
3'
2,
-10

notes of