


Township 5 South Range 32 East,

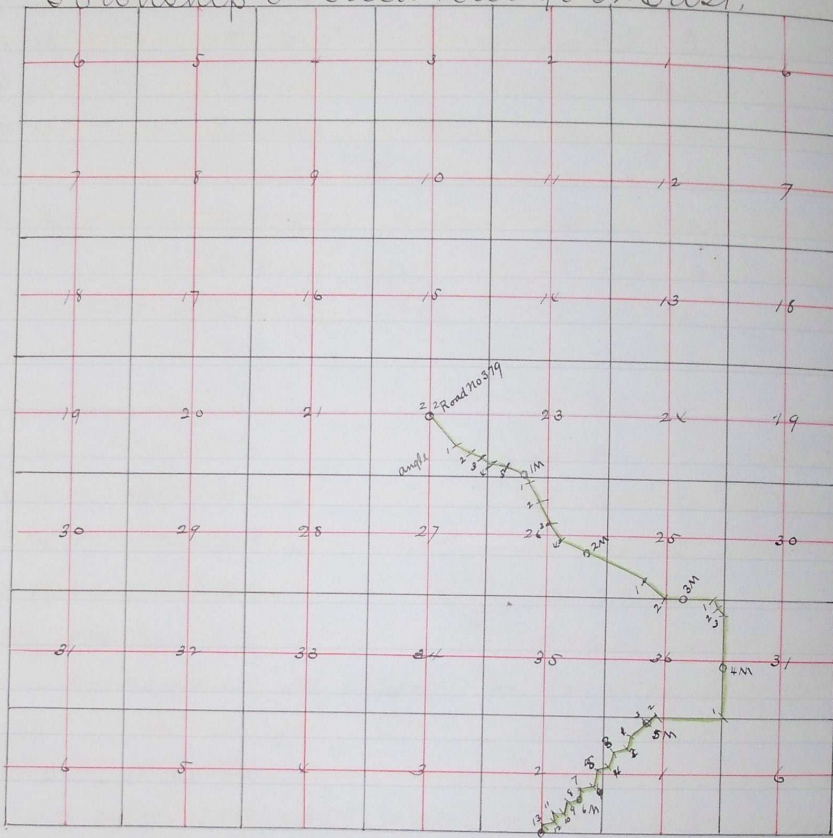

ROAD NO  
380


Dated at Alva Oct 17<sup>th</sup> 1891,

L. F. Knight  
Surveyor,

Filed Nov. 2 1891  
W. M. Pierce Clerk.

J 77