

lks. dist.

sec. 16 + 21.

ridge


bank to bank

.47 lks.

st fence  
cross  
m. p., which  
wing the  
outh of  
unchanged  
ec. 16.  
Descend hill

E. + W.  
5 chs. W. of sec. cor.

Willow Creek  
of said bridge  
the size and  
required by law.  
and survey 397.

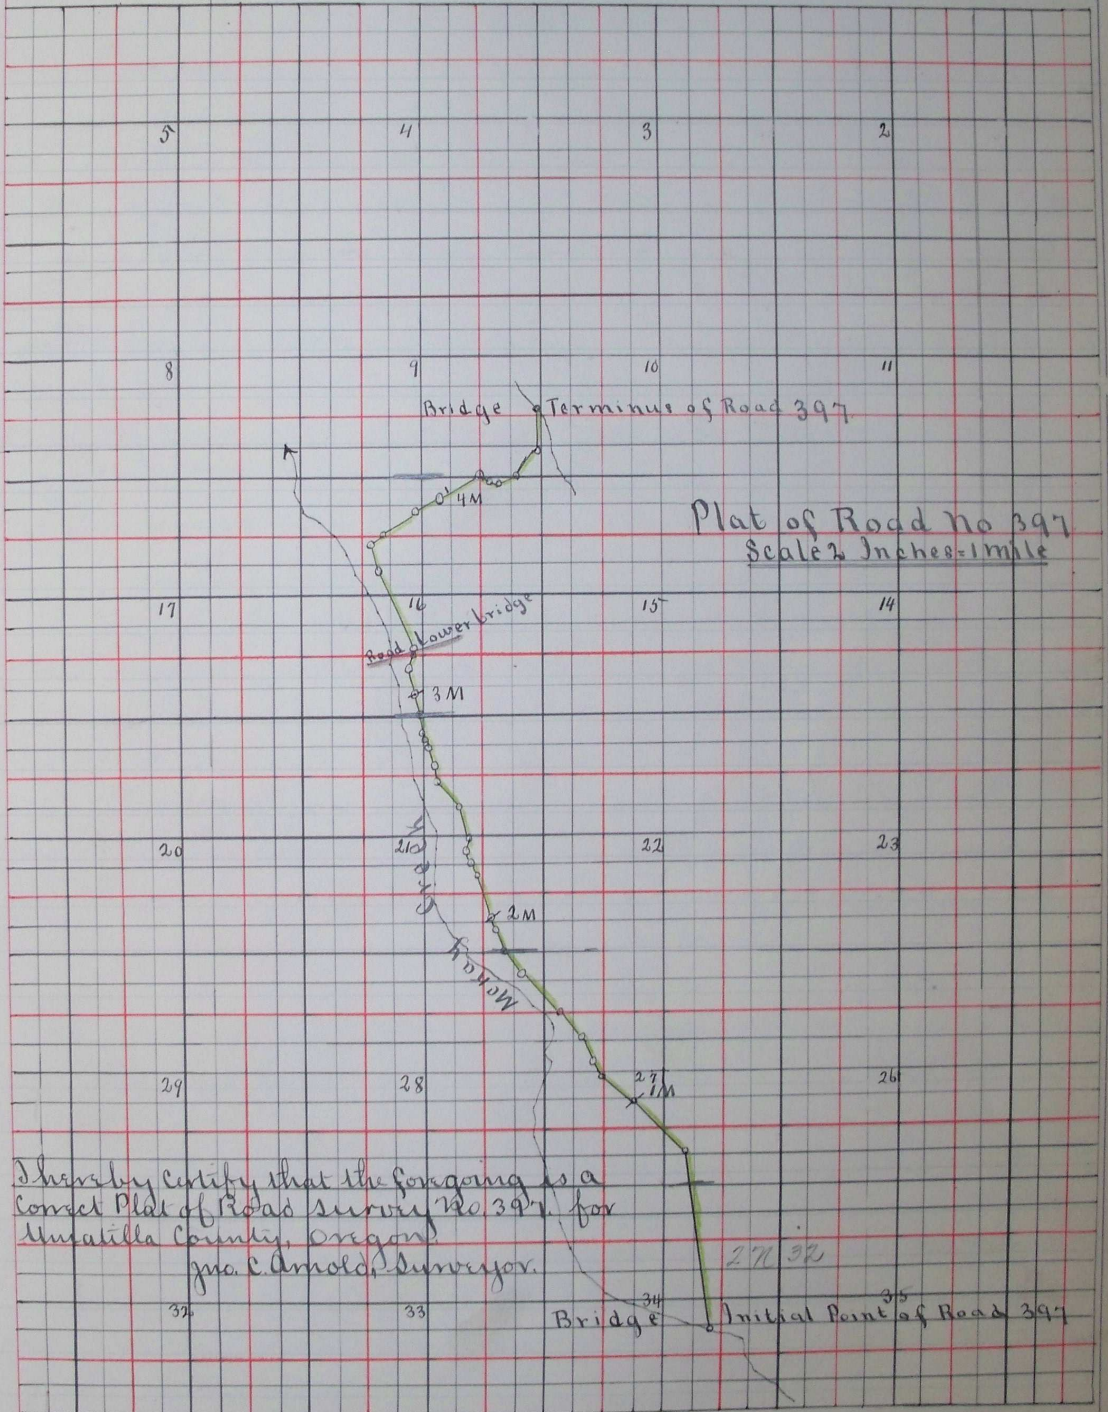

I hereby certify that the foregoing is a  
Correct Plat of Road Survey No. 397 for  
Jno. C. Arnold, Surveyor.

Filed July 13, 1892  
W. M. Pierce  
Clerk

1246