


Township No 5 S

Range 33 E W M

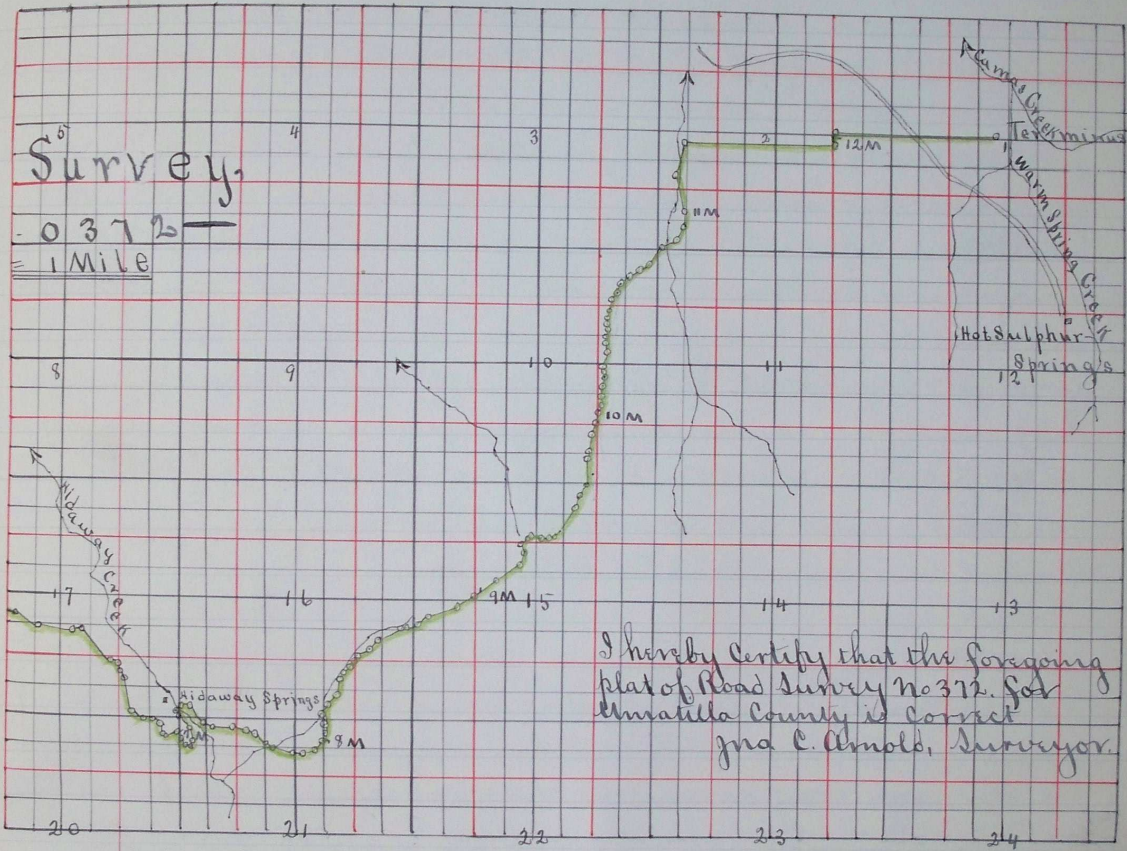

I hereby certify that the foregoing
 plat of Road Survey No 372 for
 Amatilla County is correct
 Jno C. Arnold, Surveyor

Filed July 13. 1892
 W. M. Pierce
 Clerk

1196