ROAD No
405

Plat of Road no 403

I hereby certify the following to be a correct plat of road survey 403. Section 21 Township 5 N Range 36 East of Willamette Meridian as made by me Oct 24th 1892

Jno C. Arnold
Surveyor for Umatilla County Oregon

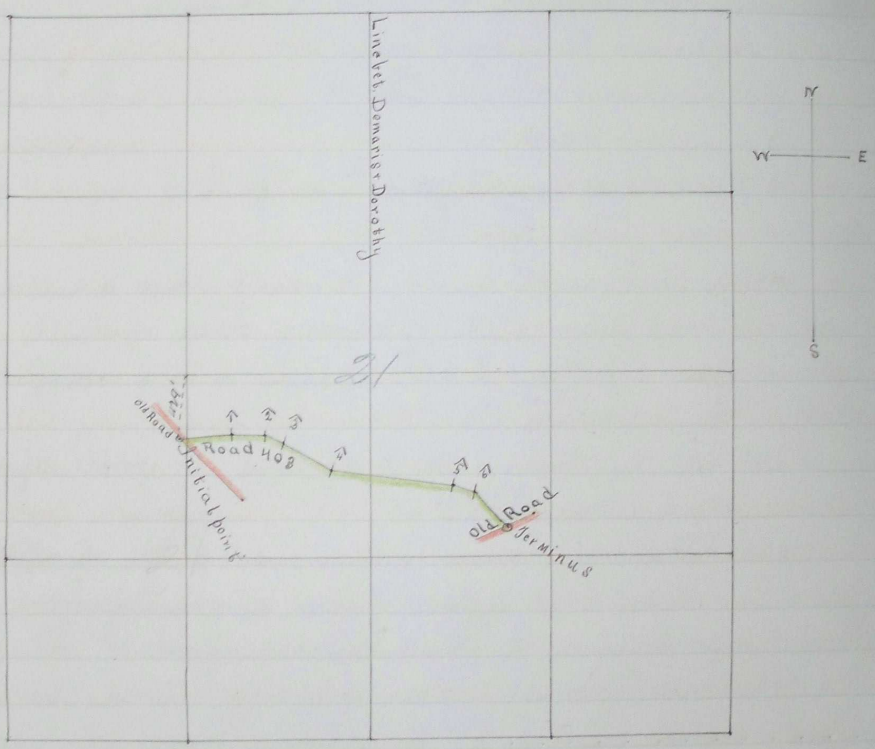

Filed Nov 9. 1892
W. M. Pinney Clerk
By H. R. Sibley Deputy

J 350