


Plat of Road No 381

Umatilla County Oregon

(Scale 2" = 1 Mile)

Old Survey from Pendleton to John Day River.

Township 5 S. Range 31 E. Township 5 S. Range 32 E. N. M.

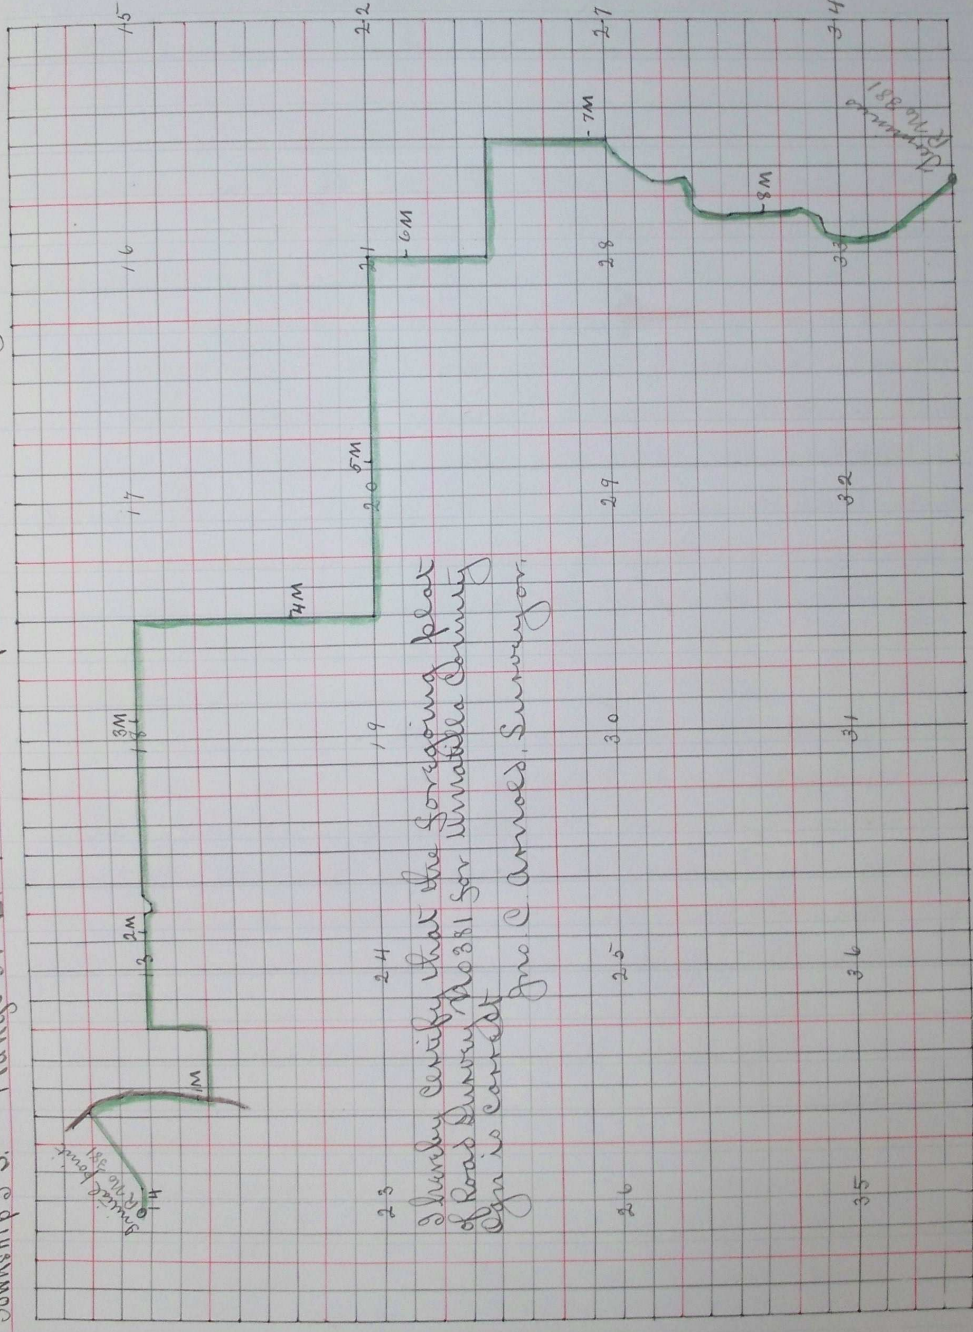

Filed July 13-1892
W. M. Pierce
Clerk

J 297

Survey
the
aw.