


Plat of Road Survey No 400

Township 4 N. Range 36 East Willamette Meridian

I hereby certify that the following is a correct plat of
 Road Survey No. 400 for Umatilla County Oregon
 Jno. C. Arnold, Surveyor.

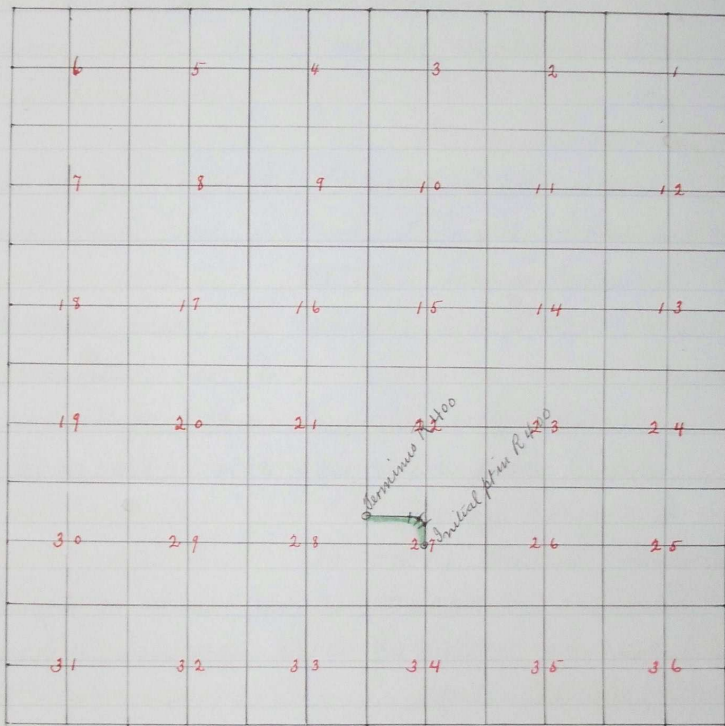

Filed Sept 5- 1892 }
 W. M. Pierce }
 Clerk } for 7/1892 } 307