


Plat of Road No 423.

I hereby Certify that the foregoing is a Correct
plat of Road Survey No 423 for Umatilla
County Oregon.

Jno. G. Arnold.
Surveyor.

Township 3 N. Range 33 E. 1/4.

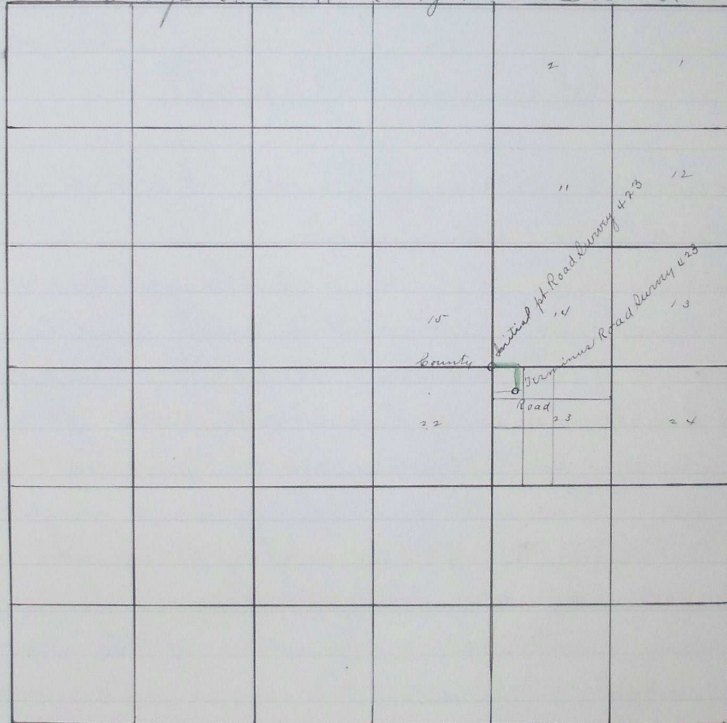

Filed July 13th 1893. }
Wm. Pierce Clerk

1524