


Plat of Road

Serpinus Road Survey 431.

Downship 4

W.P. 3

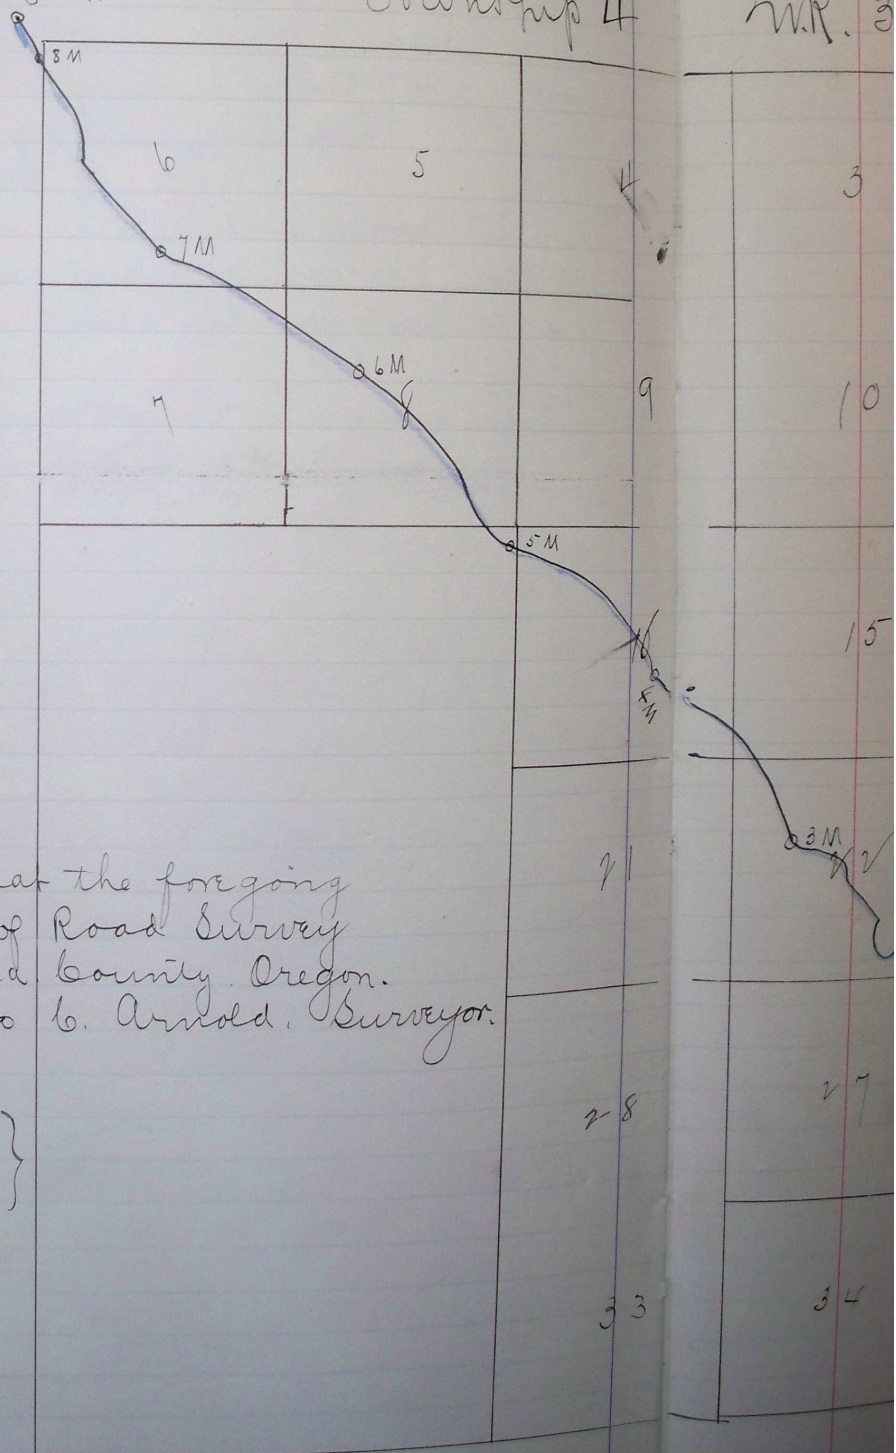

I hereby certify that the foregoing  
 is a correct plat of Road Survey  
 No 431, for Umatilla County, Oregon.  
 Jno. C. Arnold, Surveyor.

Filed, Jan'y 2<sup>nd</sup> 1894 }  
 Wm. Pierce, Clerk }

1604

Nov 8 1893