


Plat of Road Survey No. 433.

I hereby certify the following to be a correct plat of the survey of Road 433 Tp 2 NR 37 Eum. as made by me, Oct 27<sup>th</sup> 1893.

Jno L. Arnold, Surveyor  
for Umatilla Co Oregon  
Tp 2 NR 37 Eum

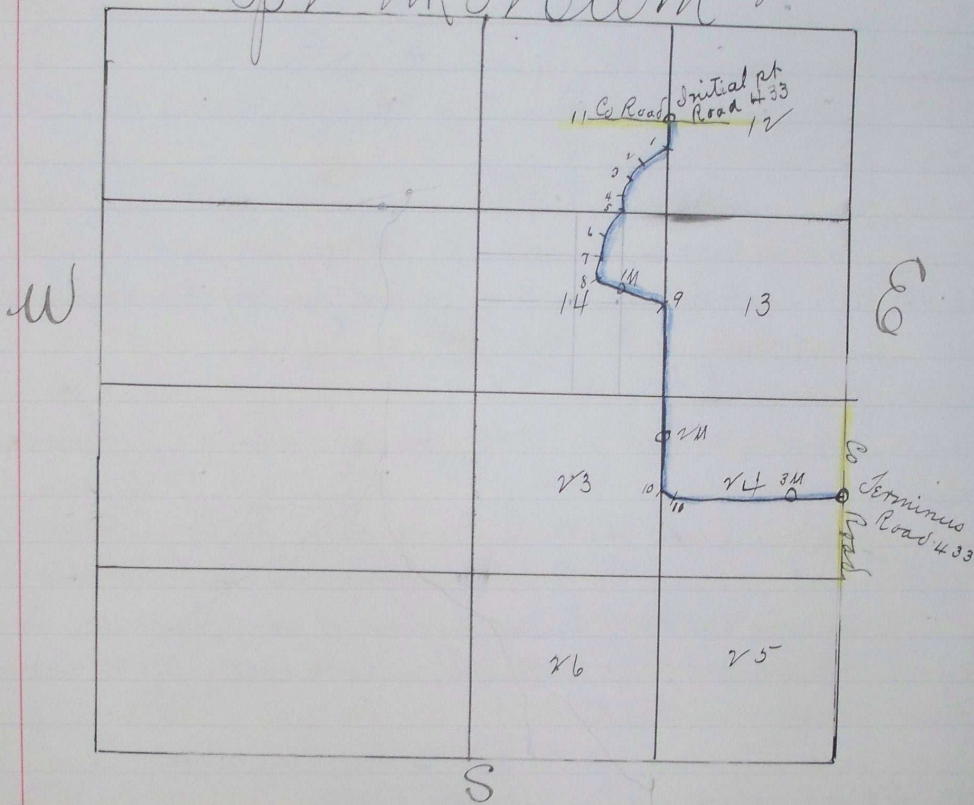

Filed. January 2<sup>nd</sup> 1894 }  
Wm Pierce. Clerk }

NR 37 1893 J605