

post four feet long and four inches square North 20 feet from point on line marked "1 M" on south face dug pits E + W and raised mound of Earth 18 inches high and 4 feet at base. Thence east on line between secs 10 + 15 50.00 chains. Set post four feet long and four inches square North 20 feet from point on line marked "2 M" on south face dug pits E + W and raised mound of Earth 18 inches high and four feet wide at base. Thence east on line between Secs 11 + 14 40.50 chains to the NE cor of the N.W. 1/4 Sec 14 in tp 3. N.R. 33 E.W.M. Set post four feet long and 4 inches square S 45° W 30 feet distant from 1/4 sec corner bet. Sec 11 + 14 marked "R.I." on N.E. face dug pits N + S and raised mound of Earth 18 inches high and four feet wide at base


October 9th 1894

John W Kimbrell
County Surveyor

Filed Oct 30th 1894

B. B. Durringtons, Clerk

Plat of Road No 451 by J. G. Kirk, et als.

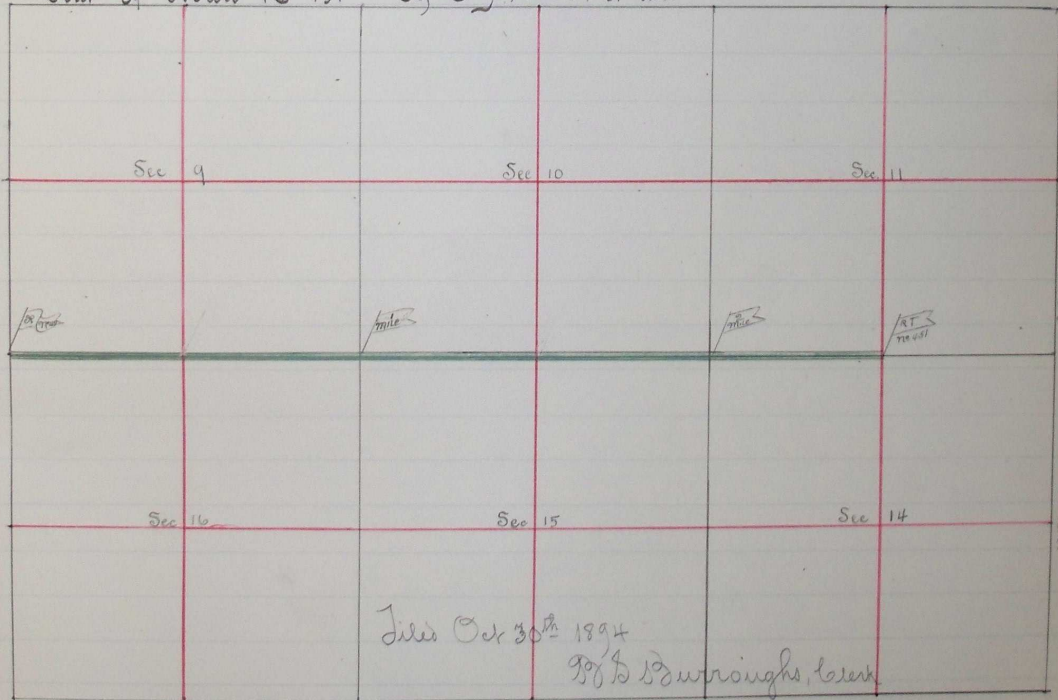

Thereby certify that the foregoing plat and field notes are correct to the best of my belief

John W Kimbrell
Co Surveyor

Nov 12 1894 J 247