County Road No 452

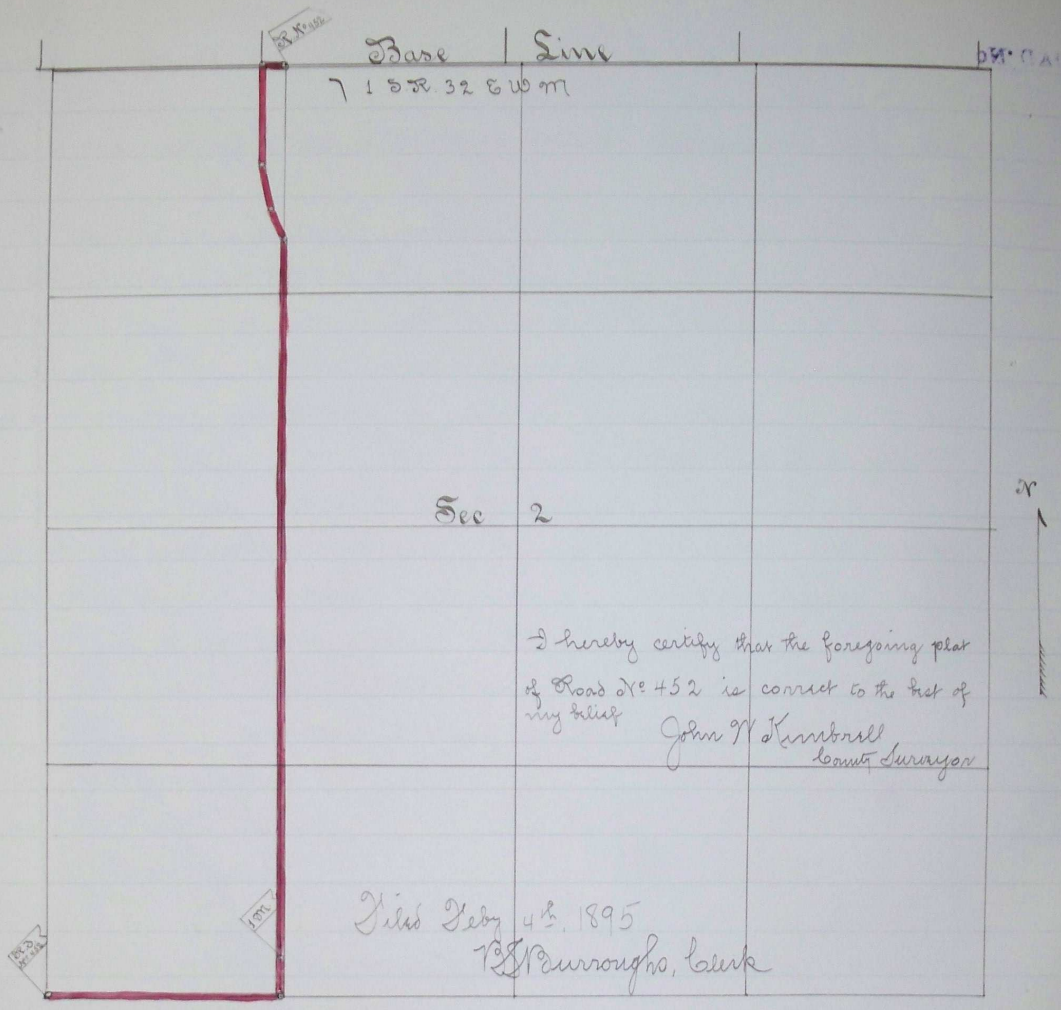

Nov 9 1894 J 239