T 6 N R 35. E

Road № 456

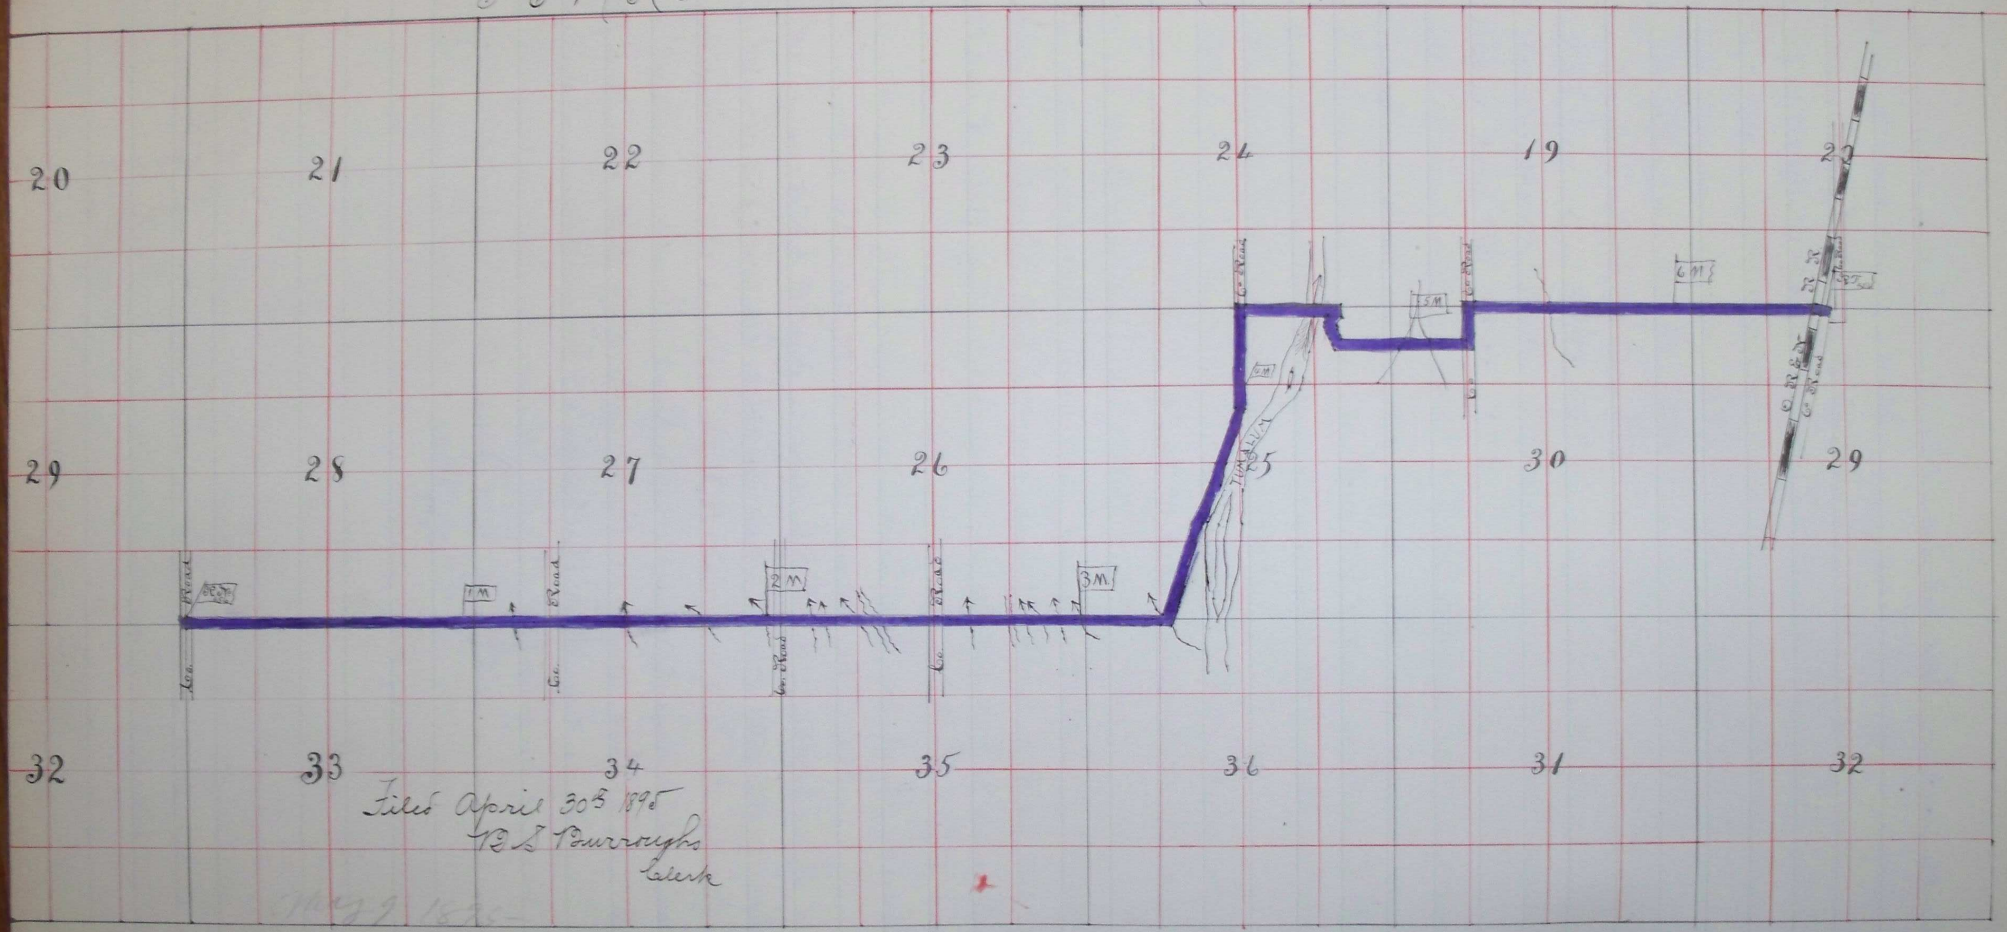

Filed April 30th 1895
T. B. Yourroughs
Clerk

I hereby certify that the above plat of Road № 456 is correct to the best of my belief
John W Kimball
County Surveyor

J 347

ROAD. No 4911