Road Nº 467.

T. 1 N. R. 32 E. W. M.

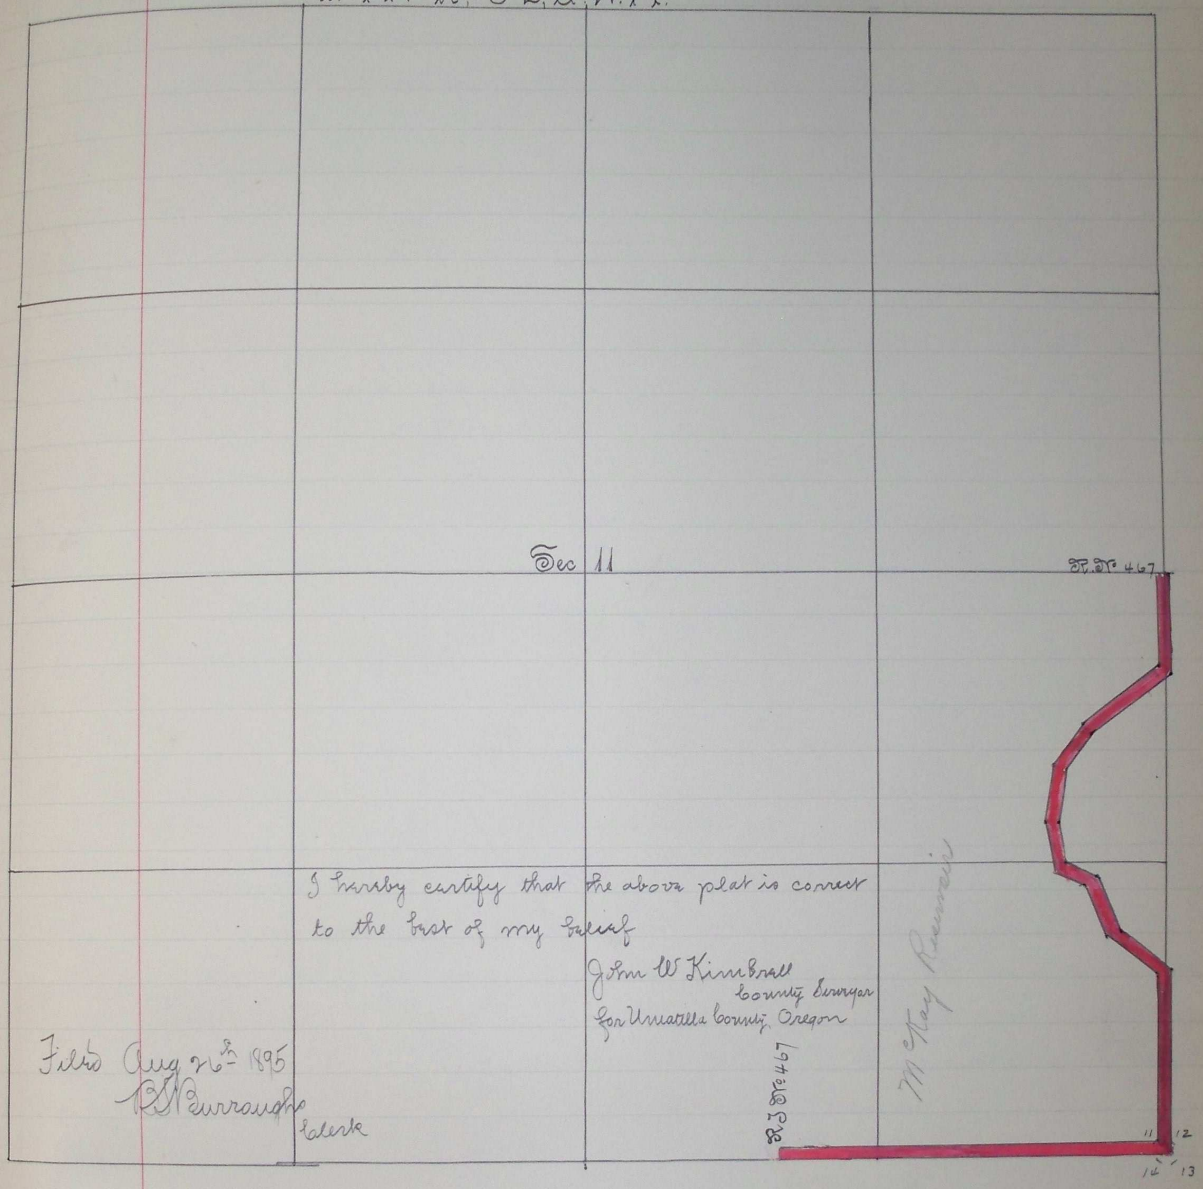

Sep 6 1895 J 415

ROAD No 467

In the matter of Viewing, Surveying and Laying Out County Road Nº 467

To the Honorable County Court of the State of Oregon for Umatilla County:

We, the undersigned, the Viewers heretofore appointed to View and Locate Road Nº 467, Submit the following report:

Pursuant to an order of the Honorable Court we met John W Kimbrell, Surveyor, at the N E cor S ½ ¼ Sec 11 T 1 N R 32 E on the 19th day of July, 1895 and were by him each duly sworn to faithfully and impartially discharge the duties of our appointments.

We called to our aid Geary Kimbrell and Thomas Jaques, Chainman, and B J Keller, marker, who were by the Surveyor each duly sworn. We viewed, surveyed and located said road Nº 467