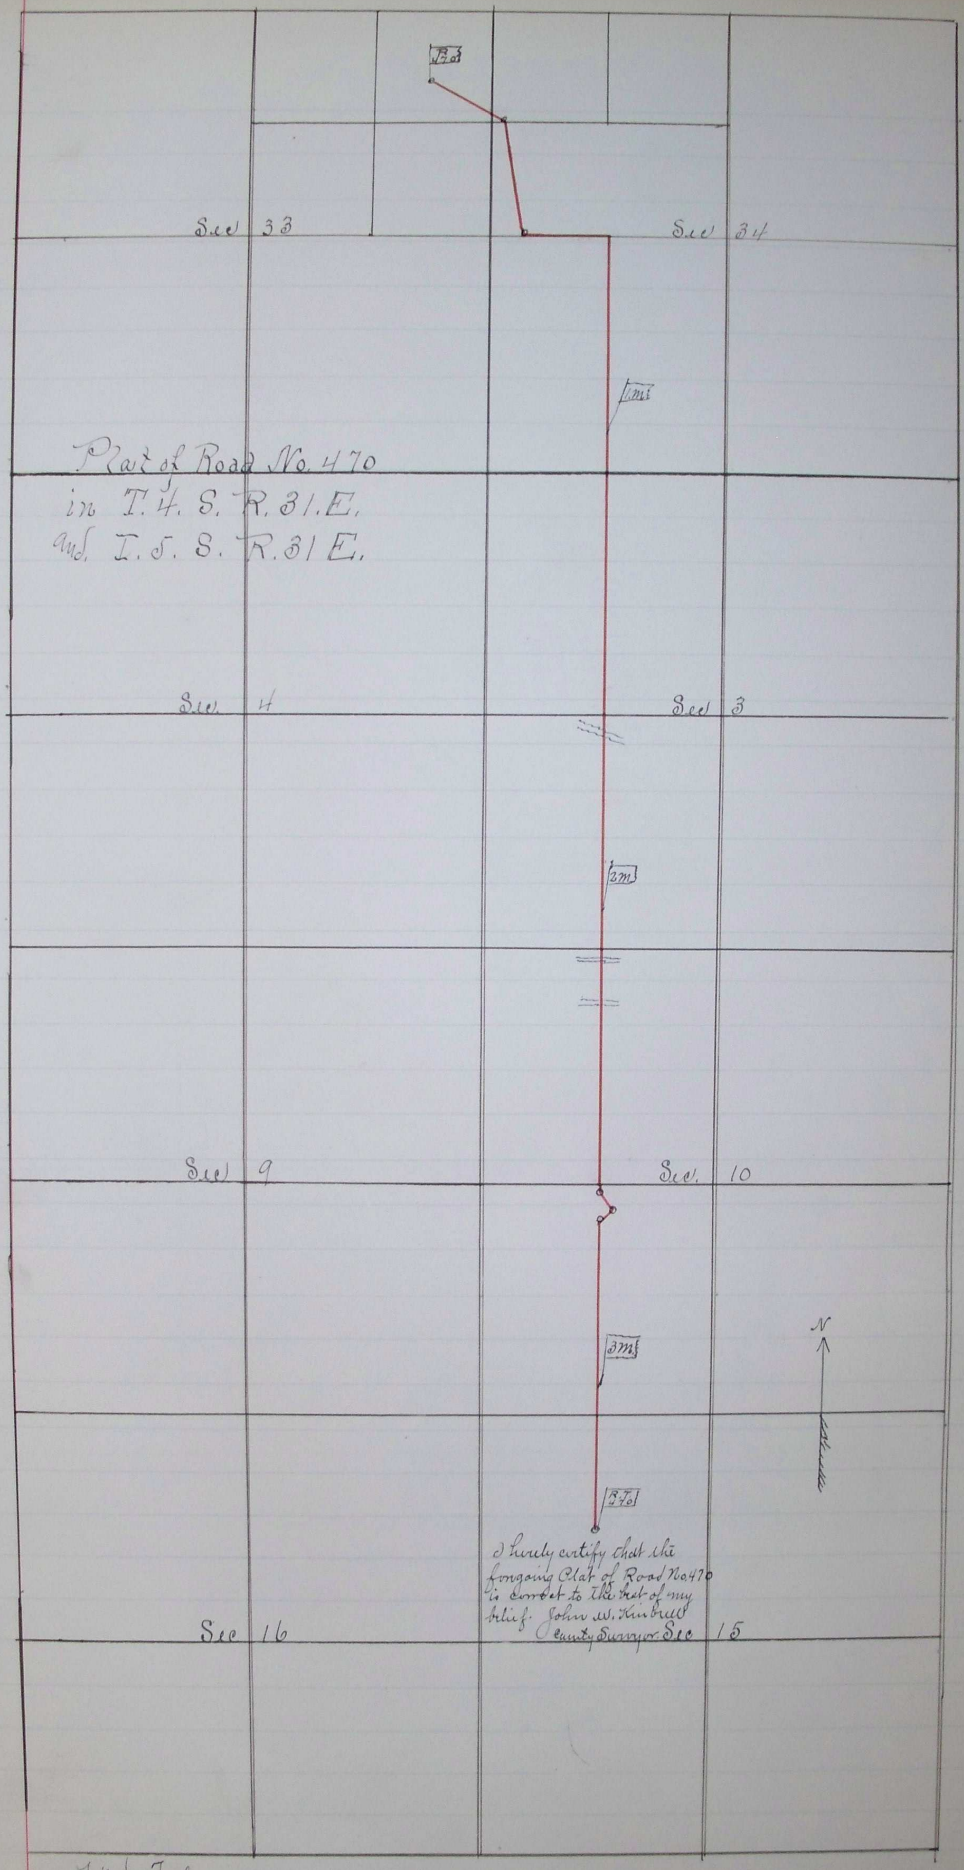

Filed February 28, 1896
B. D. Burroughs. Clerk.

May 6 1896 g 590