


Plat of County

Road No

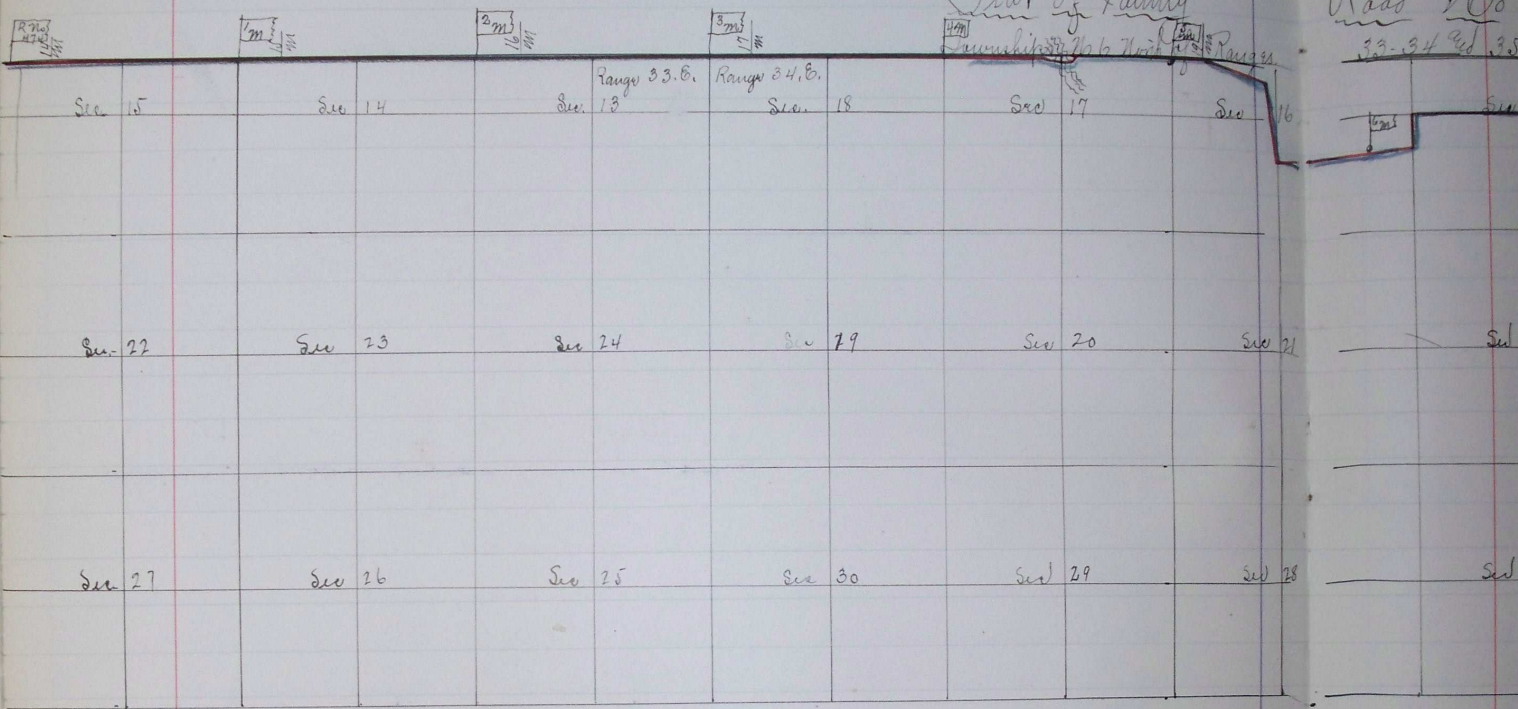

Sec 15

Sec 14

Sec 13

Sec 18

Sec 17

Sec 16

Sec 22

Sec 23

Sec 24

Sec 29

Sec 20

Sec 21

Sec 27

Sec 26

Sec 25

Sec 30

Sec 29

Sec 28

Sec

Sec