

ROAD NO  
479.

In the matter of viewing, Surveying and }  
Laying out county road No 479

To the Honorable County Court of the State of Oregon, for Umatilla County.

We, the undersigned, the Viewers heretofore appointed to view and locate Road No 479 submit the following report. Pursuant to an order of the Honorable Court we met John W Kimbrell, Surveyor, at commencement of said Road on the 15th day of April, 1896, and were by him each duly sworn to faithfully and impartially discharge the duties of our appointments.

We called to our aid Marsh Hays and Ralph Walter, Chairmen who were, by the surveyor, each duly sworn. We viewed, surveyed and located said Road No 479 as specified in our order and find the Route practicable and would most respectfully recommend the same be declared a public highway of Umatilla County, Oregon,


Marsh Hays }  
A L Frazier } Viewers Road Survey No 479  
D J Phelps }

Field Notes of Road Survey No 479

I commenced at the SW corner of the NW 1/4 NW 1/4 of Sec. 23 in T6 N R 35 E W M. I set post 4 feet long and 4 inches square 20 feet west of initial point marked P 479, dug pits and raised mound around post set 18 inches in the ground & c. Thence I run east through the center of the NW 1/4 Sec 23 var. 21° 15' E, and at 40.66 to the center of the N 1/2 Sect 23, in T6 N R 35 E W M. Set post 4x4 inches and 4 feet long 20 feet north and 20 feet West of point of terminus, marked R T No 479. Dug pits and built mound of earth around post as required by law

This, the 15th day of April, 1896

John W Kimbrell, County Surveyor

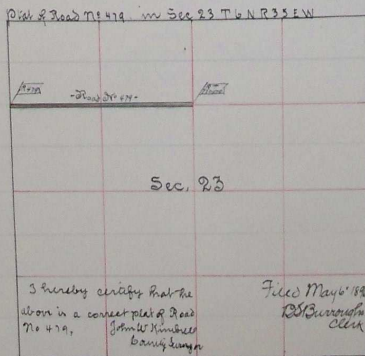

Filed May 6 1896  
B. B. Burroughs Clerk

ROAD NO  
483.

In  
and

To

Road  
for  
of  
all  
part

of  
We  
or  
re  
we

T

A  
the  
6h  
ac

SE  
4x

17  
0

1

2

3

4

5

6

7

made

8

9