

(Rugg Road)

Rd #507

Field notes of road through the lands of F Pinson, to-wit: the E 1/4 of the N 1/4 of Sec 28 in T 1 S R 31 E N M

Commencing at a point 15.00 chains south of the County Road known as the Jack Canyon Road where the same crosses the West line of the E 1/4 of the N 1/4 Sec 28, in T 1 S R 31 E N M.


- Thence N 61° 30' E 12.50 chains
- " N 37° 50' E 6.45 "
- " N 15° " E 6.87 "
- " N 37° 15' E 4.55 "

To the County road in Jack Canyon leading from Pilot Rock to Willow Springs, and ending at a point 4.38 chains south of the NE corner of the N 1/4 Sec 28 in T 1 S R 31 E N M.

I hereby certify that the above plat of proposed road is correct to the best of my knowledge and belief; as surveyed by me on the 12th day of May, 1897

John W. Humbrell

Surveyor for Umatilla County, Oregon

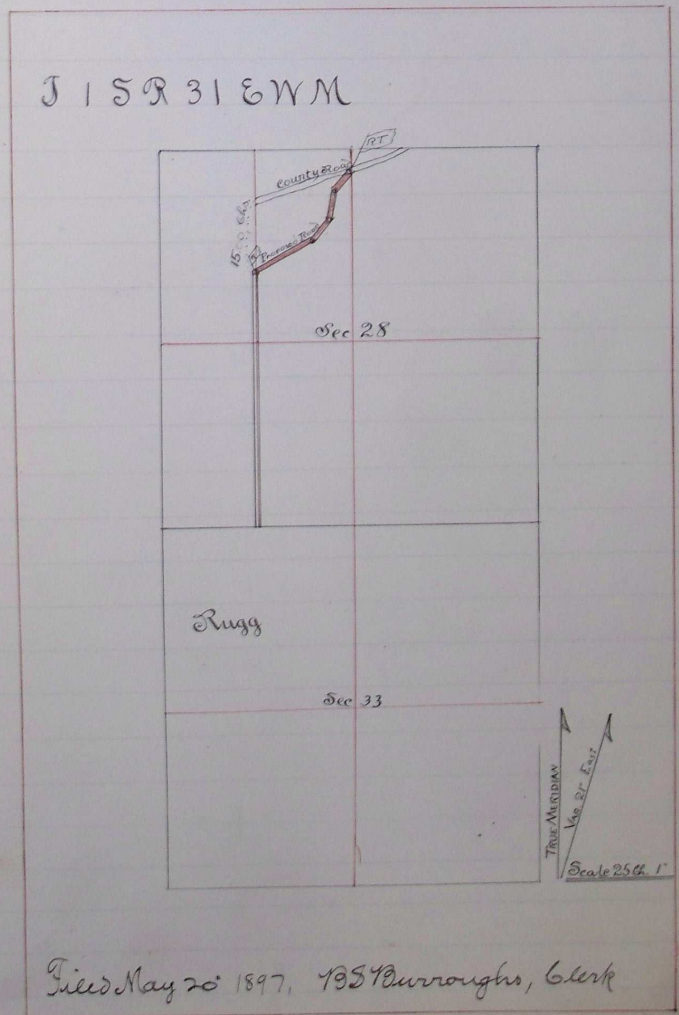

Filed May 20 1897, 1957 Burroughs, Clerk




Scale 25 Ch. 1'

Road #486
1897,

Umatilla

106