

In the Matter of Viewing, Surveying and Laying out County Road No 489

To the Honorable County Court of the State of Oregon, for Umatilla County:
We, the undersigned, the viewers heretofore appointed to view and locate Road No 489, submit the following report: Pursuant to an order of the Honorable Court we met John W Kimbrell, Surveyor, at Echo, on July 30th, 1897, and were by him each duly sworn to faithfully and impartially discharge the duties of our appointments.

We called to our aid Gary Kimbrell, A J Dillon, Chainmen, O Fall, Marker, who were by the surveyor each duly sworn. We viewed survey and located said road No 489, as specified in our order and find the route practicable and would most respectfully recommend the same be established and declared a public highway, of Umatilla County, Oregon

James Taylor }
J B Nye } Viewers, Road Survey No 489
A J Dillon }

Field Notes of County Road No 489

I commenced in the center of the E 1/2 Sec 17, Twp 3 North Range 29 E N N

Set post 4x4 inches square and 4 feet long, 20 feet east of initial point, marked R 489, Built mound 18 inches high and 4 feet wide around post, and dug pits N + S.


| | | | | |
|--------|-------------|-------|-------|---------------|
| Thence | North | 27.13 | | < 1 |
| " | N 56° 45' W | 14.64 | 41.77 | 2 |
| " | N 58 W | 8.05 | 49.82 | 3 |
| " | West | 21.70 | 71.52 | Road Terminus |

Set post 4x4 inches square and 4 feet long 30 feet NE of point marked R. T. 489, Built mound 18 inches high around post and dug pits east and north of post

I hereby certify that the foregoing are the true field notes of Road No 489 as surveyed by me on the 30th day of July, 1897

John W Kimbrell
Surveyor for Umatilla County, Oregon

Filed August 14th 1897
B B Burroughs
Clerk

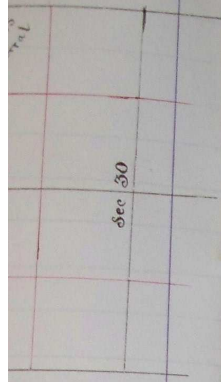

accompanying as surveyed 97 County, Oregon

Clark

1/16 155

County Road No 489
Surveyor