


Plat of Road No 266

Township 6 N. R 35 E

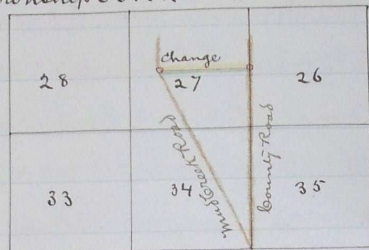

Book G. page 340

" G. " 398

Recorded Oct 25 1886

G. A. Hartman
County Clerk.

I hereby certify this to be a true
plat of change in Co Road No 266,
Petition of Andrew Carlson.

Jno C. Arnold
Surveyor.