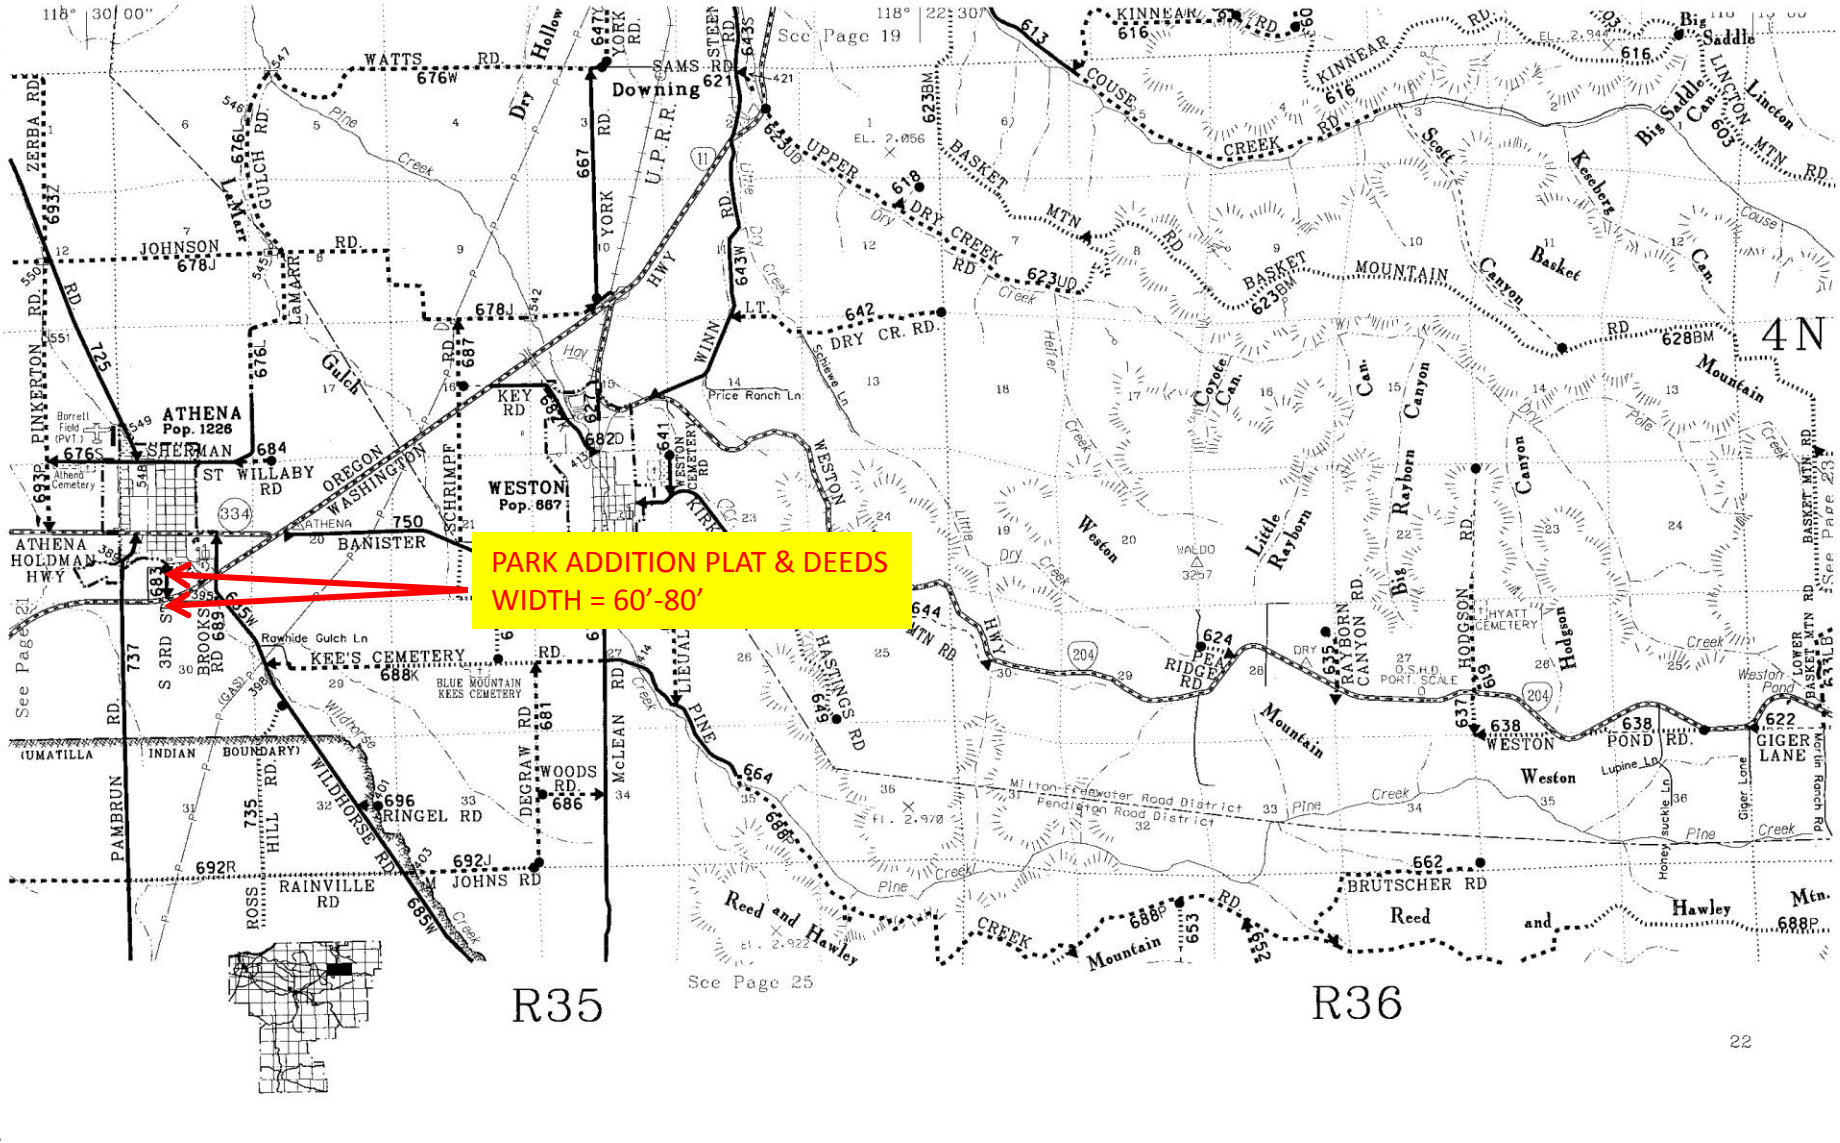
PARK ADDITION PLAT & DEEDS
WIDTH = 60'-80'
ATHENA
Pop. 1226
WESTON
Pop. 667
R35
R36
4N
See Page 19
See Page 21
See Page 23
See Page 25