


309


309

TOWNSHIP 6 N. RANGE 33 E. W. M.

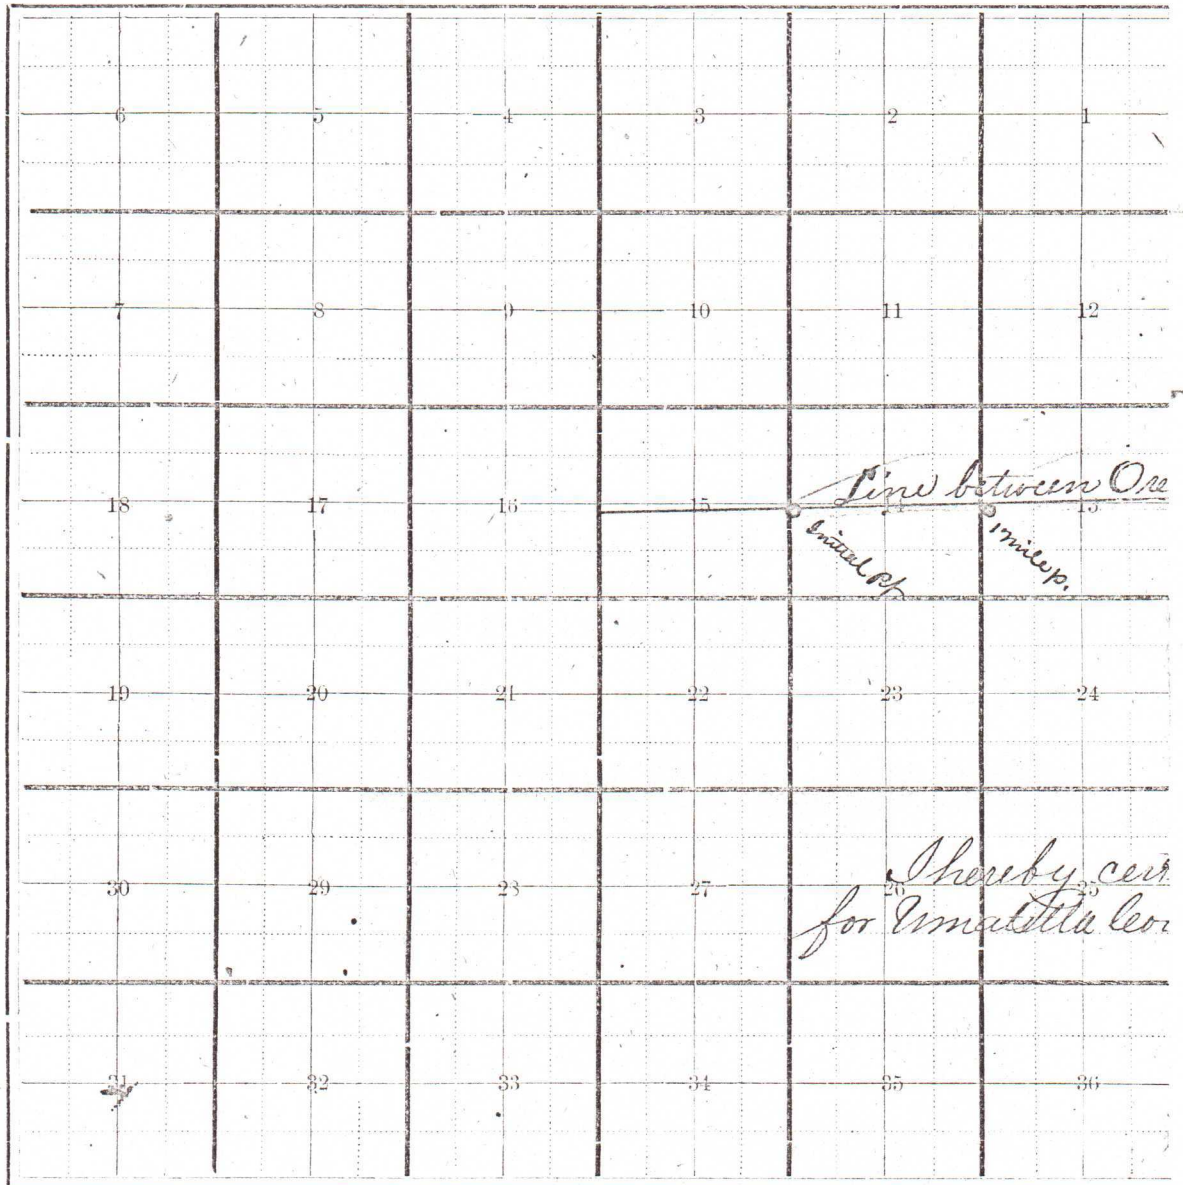

309


TOWNSHIP 6N RANGE 34E. W. M.

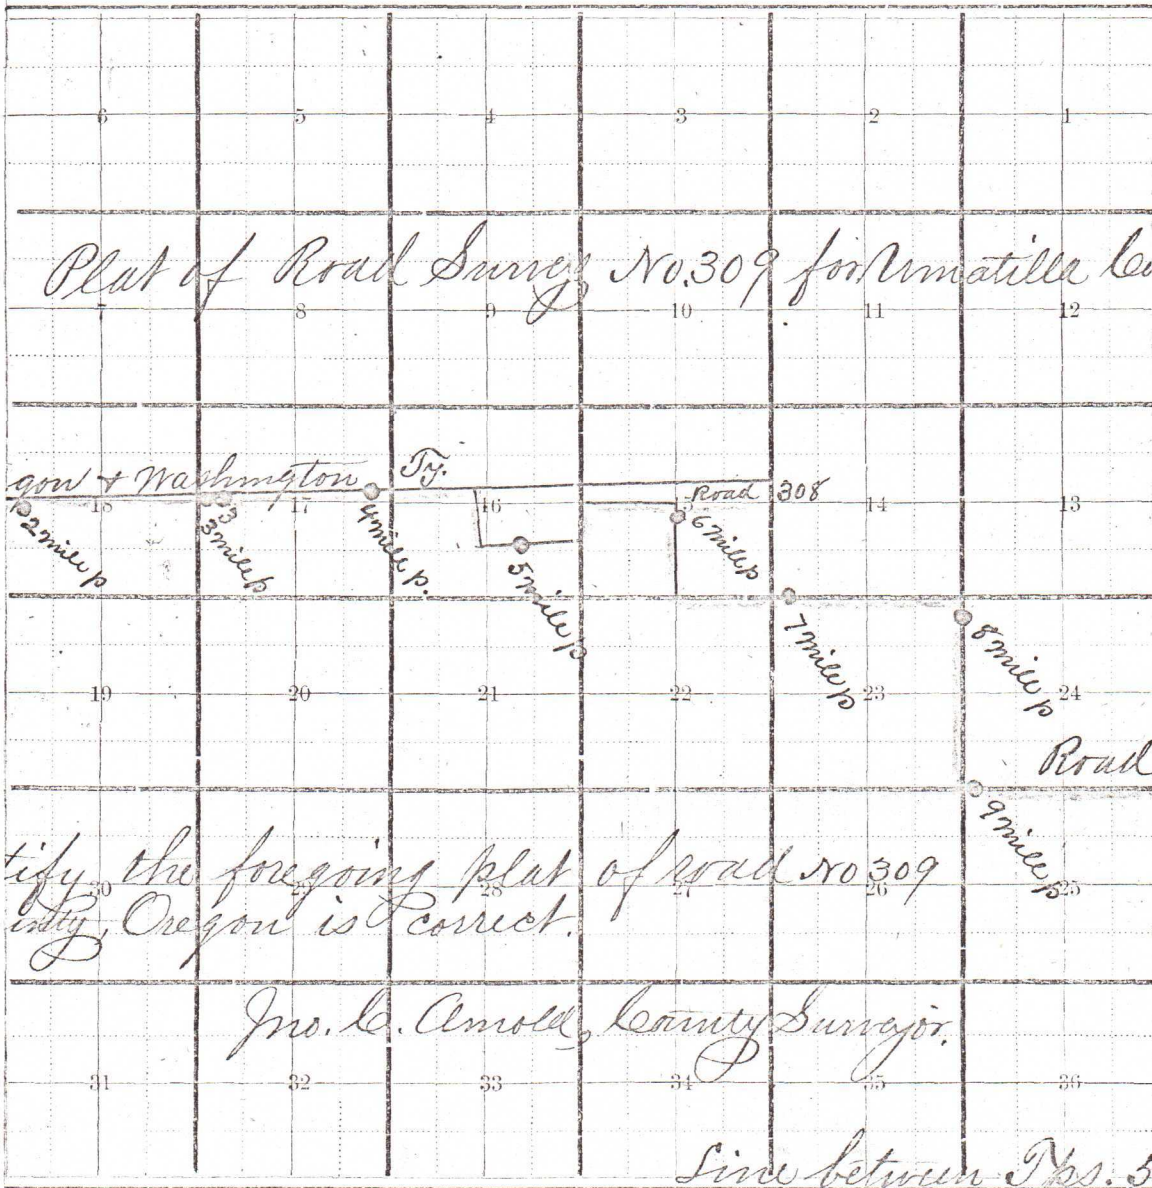

309

309

TOWNSHIP 6 N. RANGE 35 E. W. M.

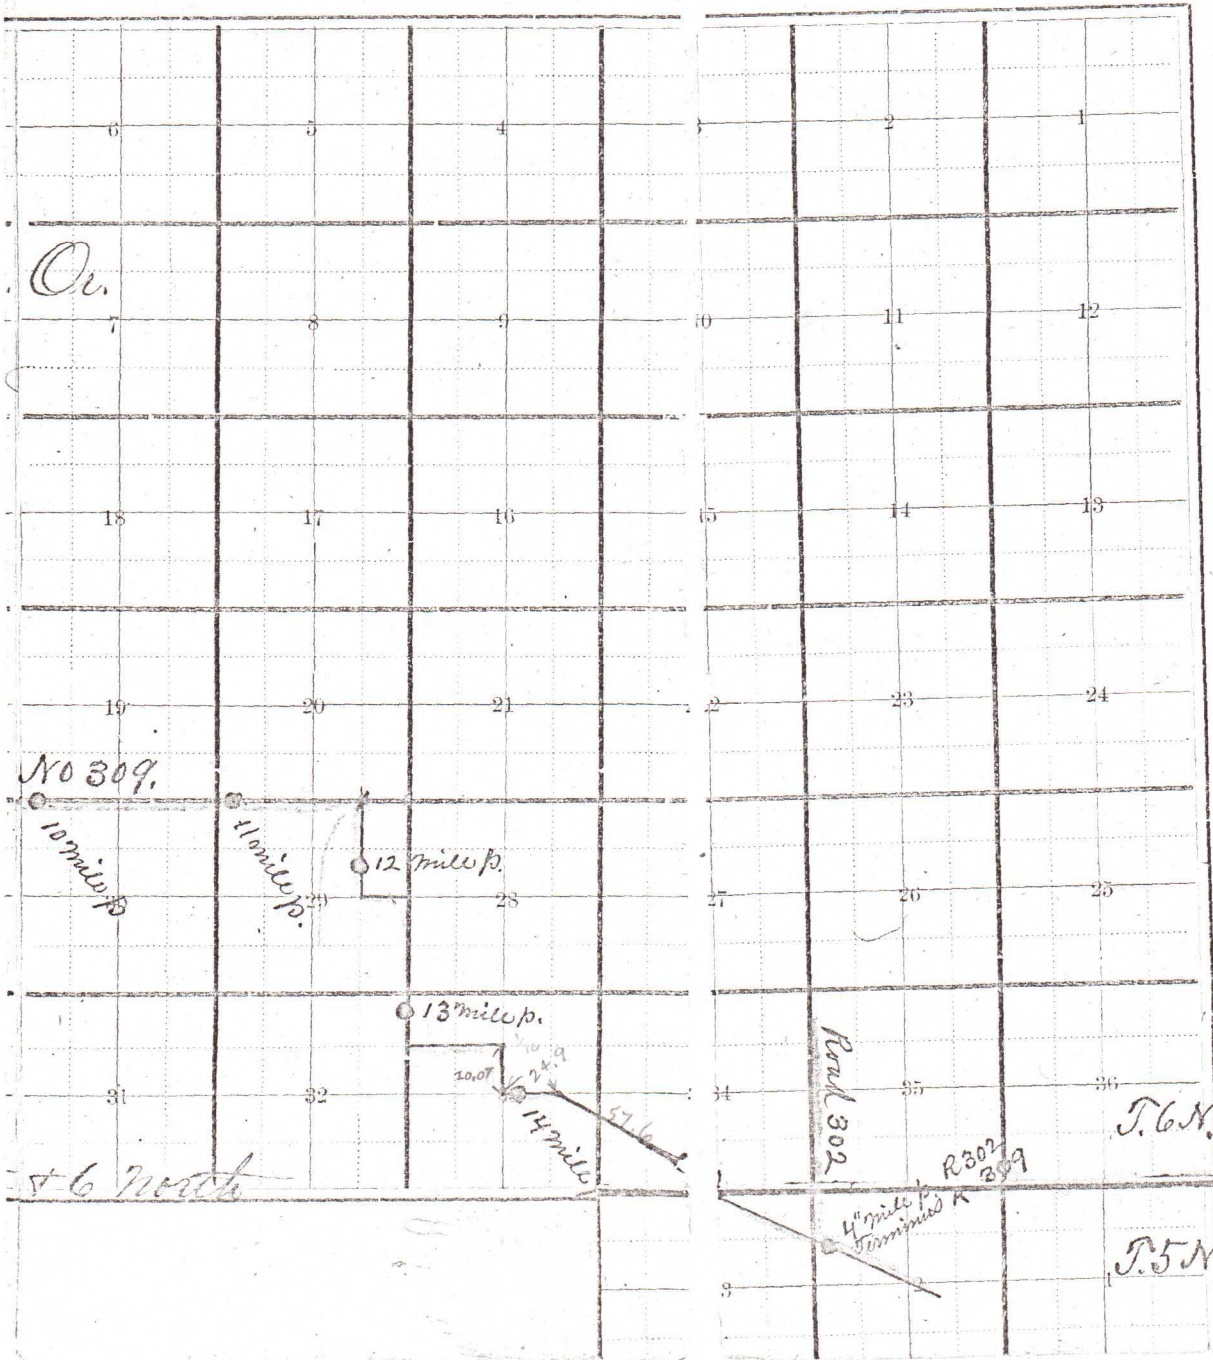

608