24A

Plat of Road

Scale 1 in. to the mile.

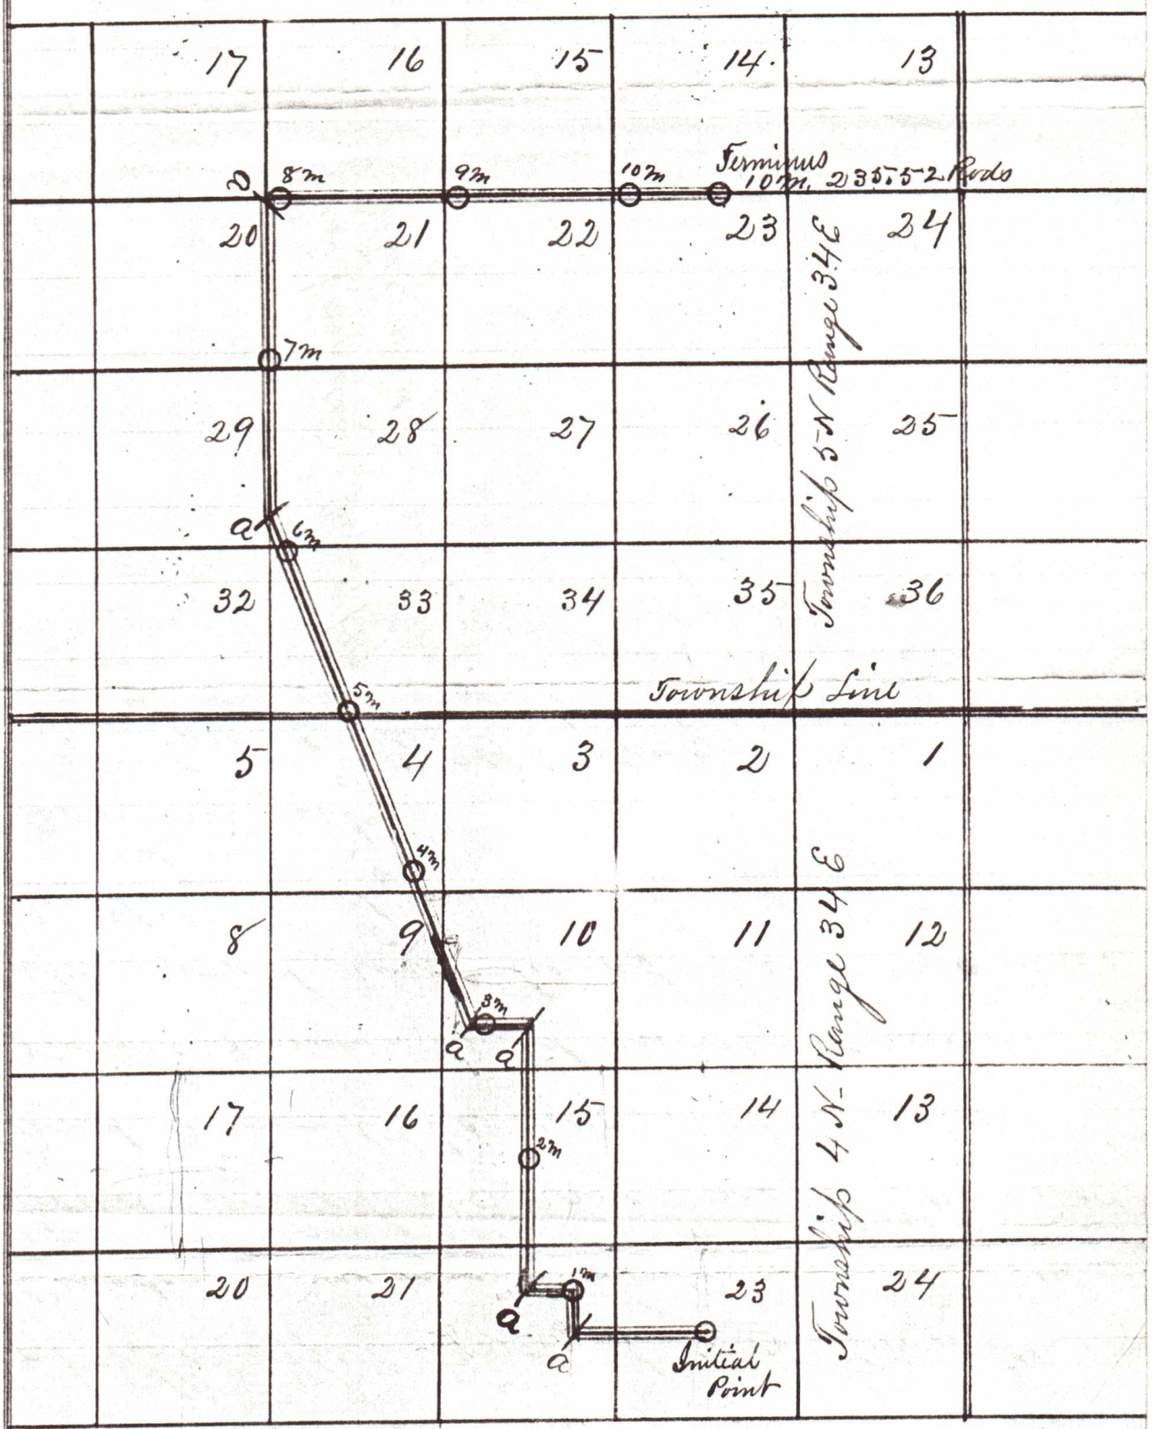

Jno. C. Arnold.
Dpty. Surveyor.