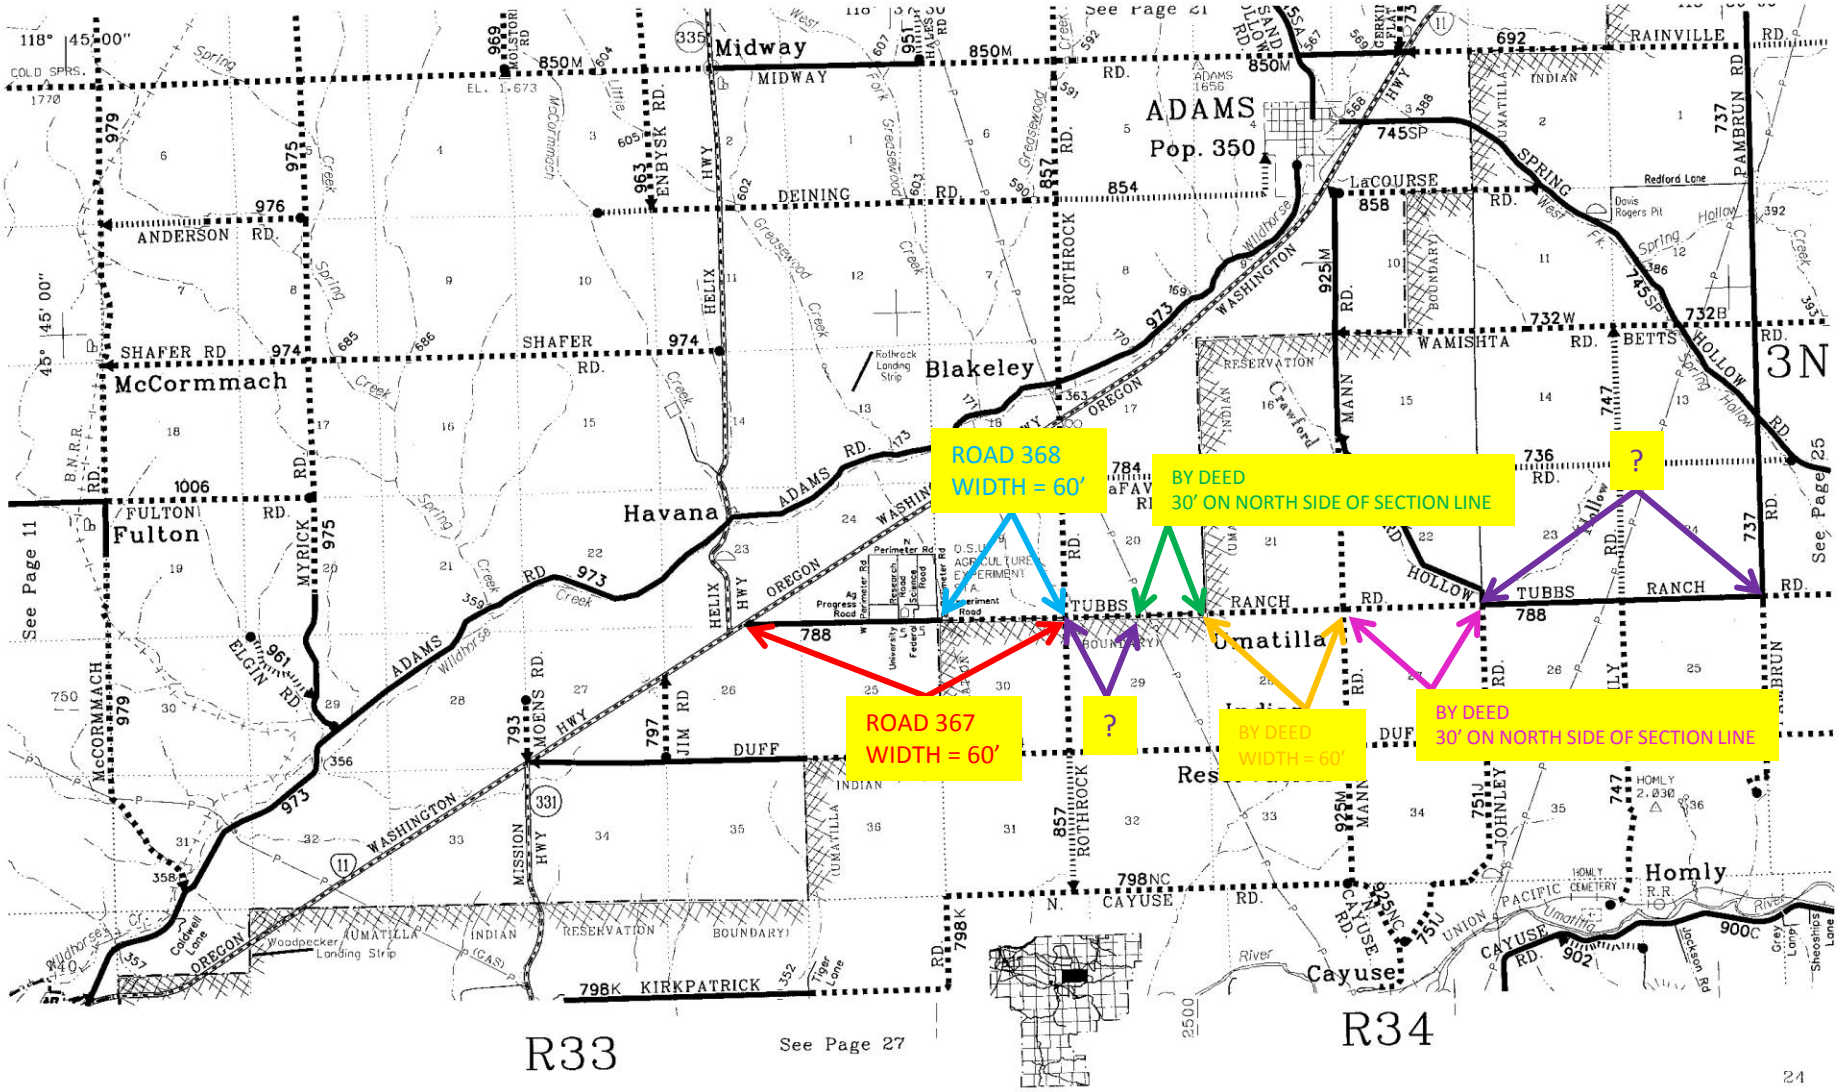
ROAD 368
WIDTH = 60'
BY DEED
30' ON NORTH SIDE OF SECTION LINE
?
ROAD 367
WIDTH = 60'
?
BY DEED
WIDTH = 60'
BY DEED
30' ON NORTH SIDE OF SECTION LINE
Midway
ADAMS
Pop. 350
Blakeley
Havana
Fulton
McCormmach
Umatilla
Homly
Cayuse
R33
R34
3N
See Page 11
See Page 27
See Page 21
See Page 25

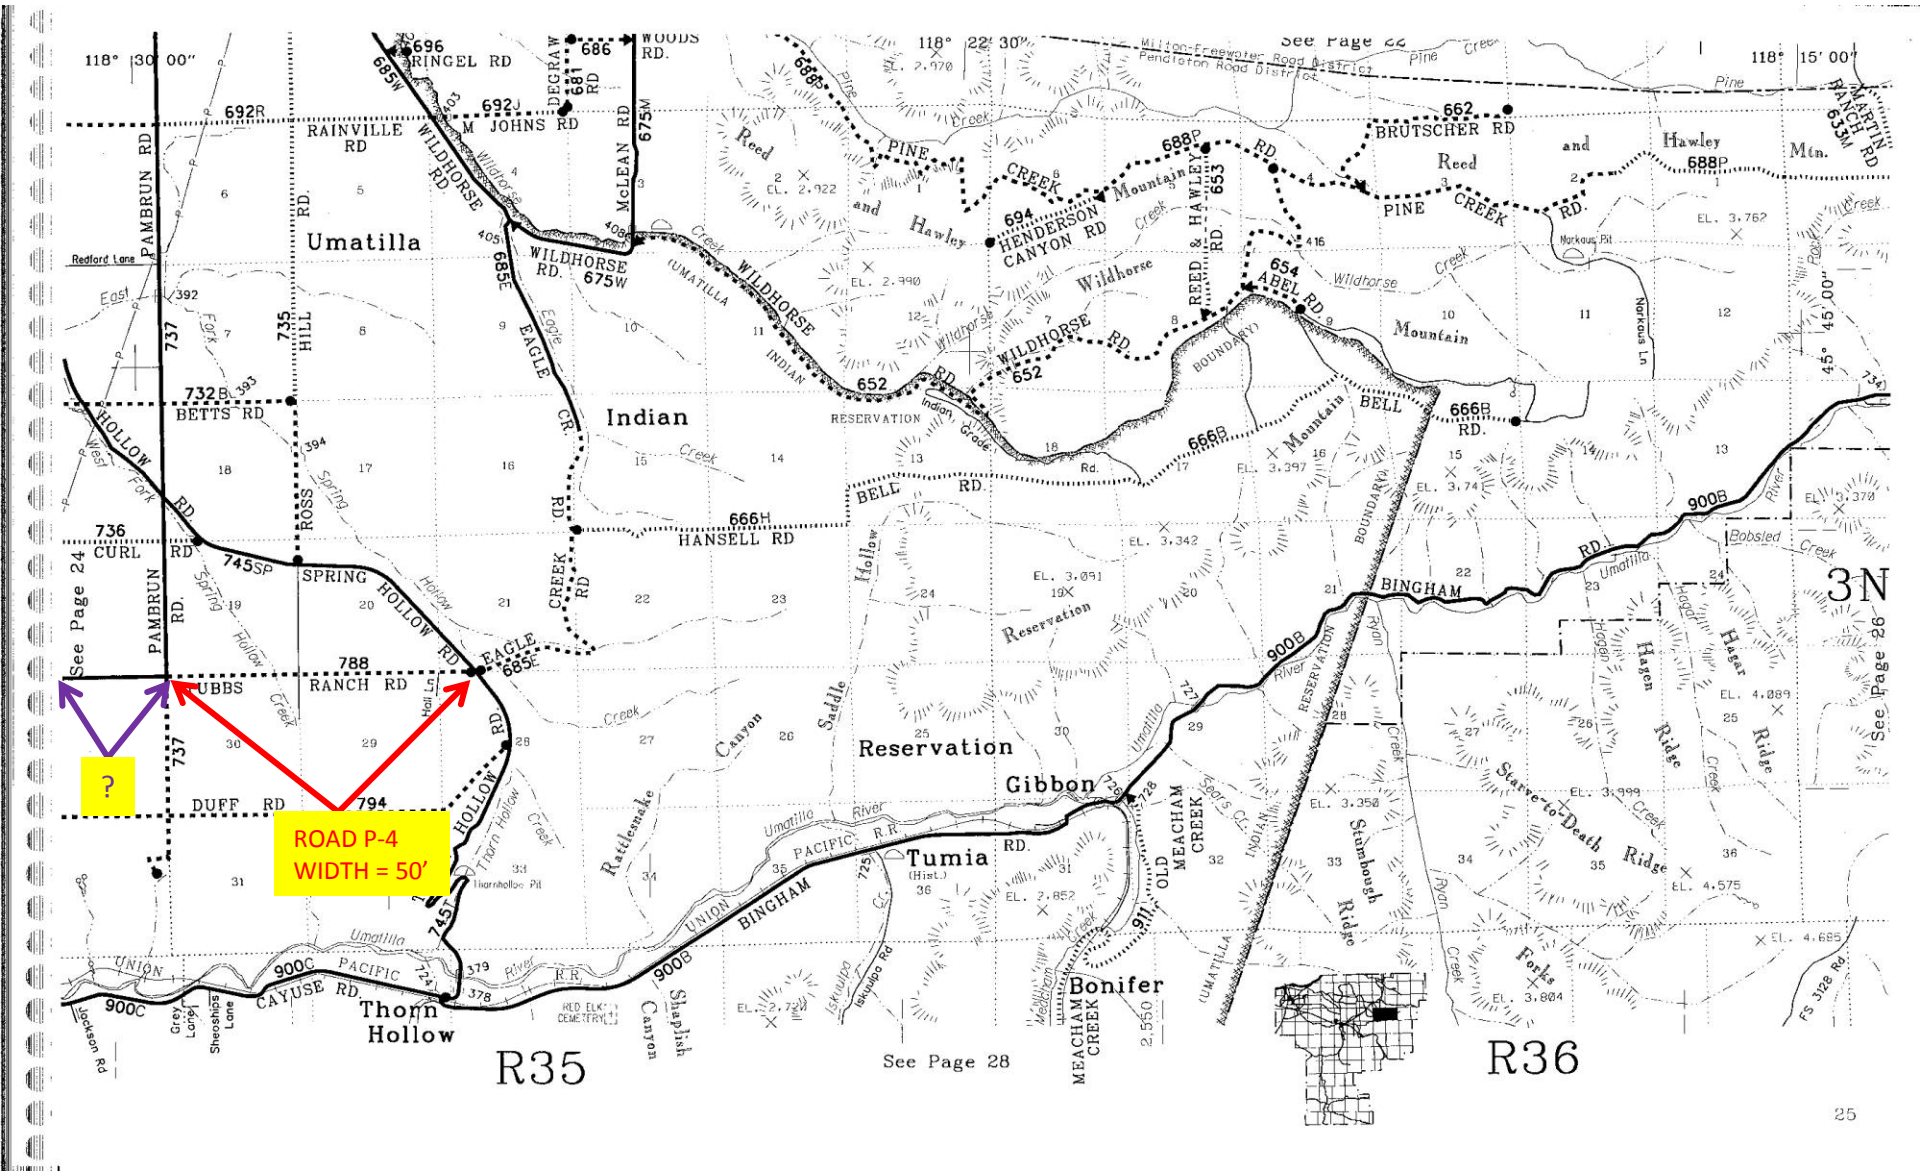
118° 30' 00"
118° 22' 30"
118° 15' 00"
45° 45' 00"
See Page 24
See Page 26
See Page 28
3N
R35
R36
PAMBRUN RD
RAINVILLE RD
M JOHNS RD
RINGEL RD
WOODS RD.
DEGRAW RD
McLEAN RD
WILDHORSE RD
Umatilla
Indian
Reservation
Gibbon
Tumia
Bonifer
Thorn Hollow
BETTS RD
ROSS
HILL
CURL RD
SPRING HOLLOW RD
EAGLE CR.
CREEK RD
HANSELL RD
BELL RD
HENDERSON CANYON RD
REED & HAWLEY RD
ABEL RD
BRUTSCHER RD
PINE CREEK RD
Reed and Hawley
Hawley Mtn.
Mountain
BINGHAM
UBBS RANCH RD
DUFF RD
CAYUSE RD.
UNION PACIFIC R.R.
Umatilla River
Thornhollow Pit
Markaus Pit
Redford Lane
Jackson Rd
Grey Lane
Sheoshios Lane
Shaplish Canyon
Rattlesnake Canyon
Saddle Hollow
Starve-to-Death Ridge
Stambough Ridge
Hagen Ridge
Hager Ridge
Bobsled Creek
Forks
Iskulpa Rd
FS 3128 Rd
OLD MEACHAM CREEK
MEACHAM CREEK
Milton-Freewater Road District
Pendleton Road District
RESERVATION BOUNDARY
INDIAN RESERVATION
RED ELK CEMETERY
?
ROAD P-4
WIDTH = 50'