



1642

Sec. 4 T.326. R.34E.

Line between Tps. 3 & 4 T. 34 E.

Center Sec. 4. T.326. R.34E.  
Initial point

Scale. 5 1/2 in to 1 mile

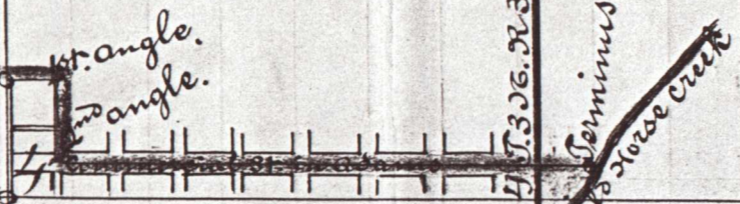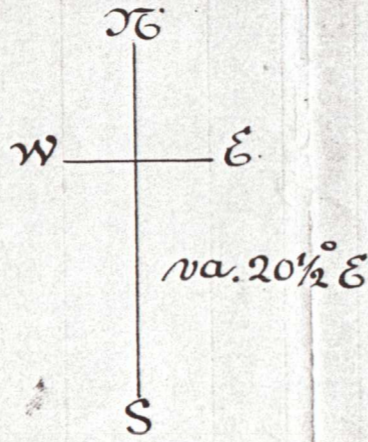

Line between Sec. 3 & 4 T.326. R.34E.

Plat of change in Co. road 164.  
as surveyed July 18<sup>th</sup> 1884.

Jno. C. Arnold, Survr.

3