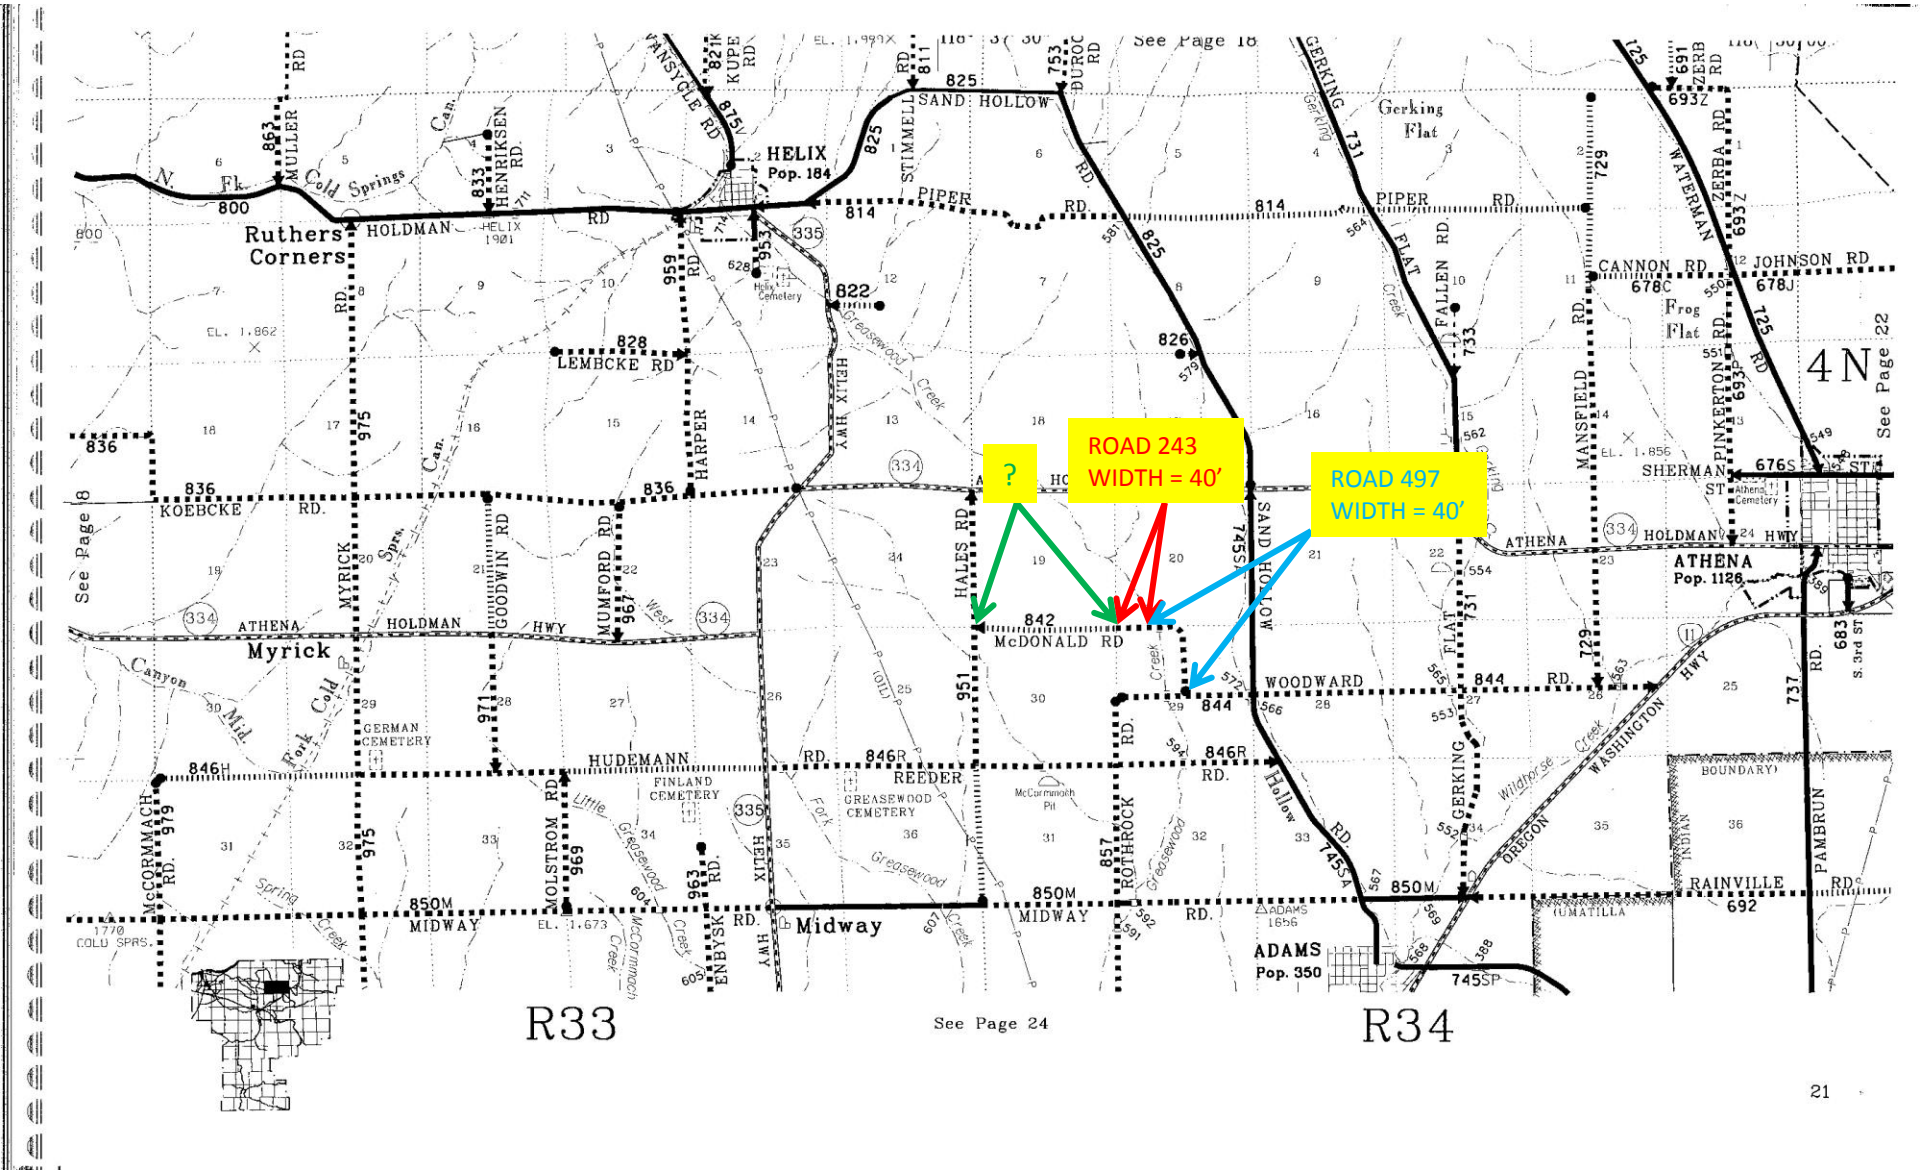
?
ROAD 243
WIDTH = 40'
ROAD 497
WIDTH = 40'
HELIX
Pop. 184
Ruthers
Corners
HOLDMAN
Myrick
ATHENA
Pop. 1126
Midway
ADAMS
Pop. 350
McDONALD RD
SAND HOLLOW
WOODWARD
PIPER RD.
LEMBCKE RD
KOEBCKE RD.
HUDEMANN RD.
REEDER RD.
CANNON RD
JOHNSON RD
SHERMAN ST
HOLDMAN HWY
WASHINGTON HWY
OREGON TRAIL
RAINVILLE
Gerking Flat
Frog Flat
R33
R34
4N
See Page 18
See Page 22
See Page 24