


T. 5. N. R. 32. E. W. N.

Plat of Change in Road No. 124

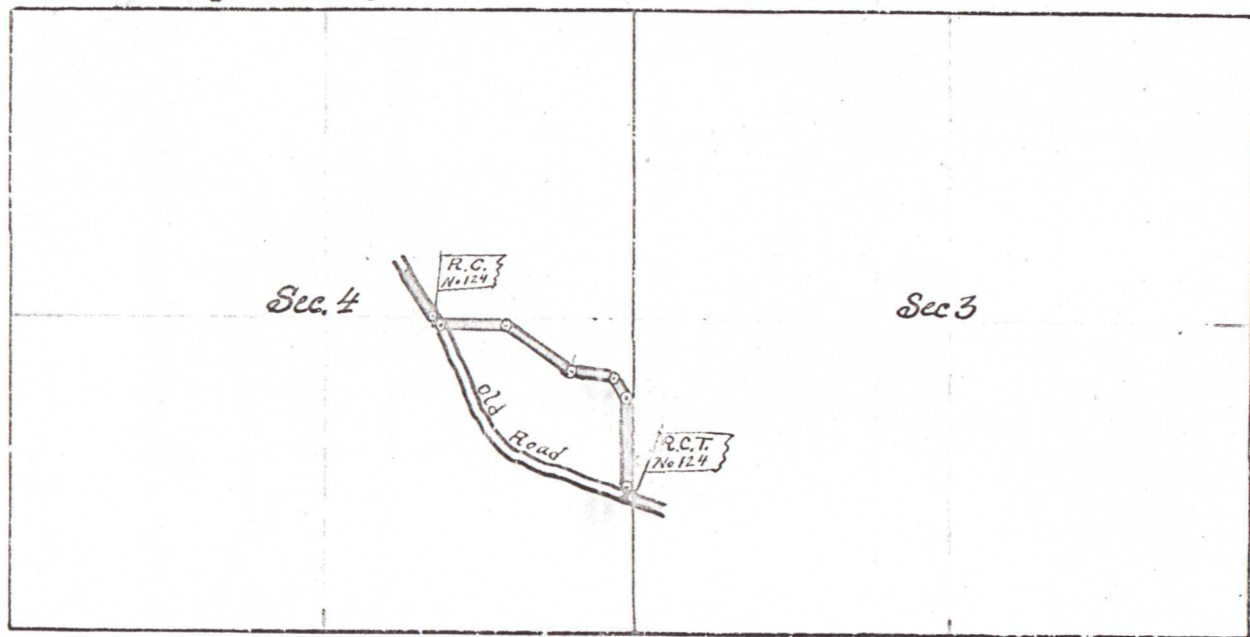

I hereby certify that the foregoing is a correct Plat of Change in Road No. 124 as surveyed by me on the 16th day of May 1898

John W. Kimbrell Surveyor
for Matilda Cr Oregon

by J.W. Kimbrell
1898
124

124

124