

4B-26-15
T2N R33 E


4B-12-10
T2N R33 E

T2N R33 E

See A&R 285



Section 12

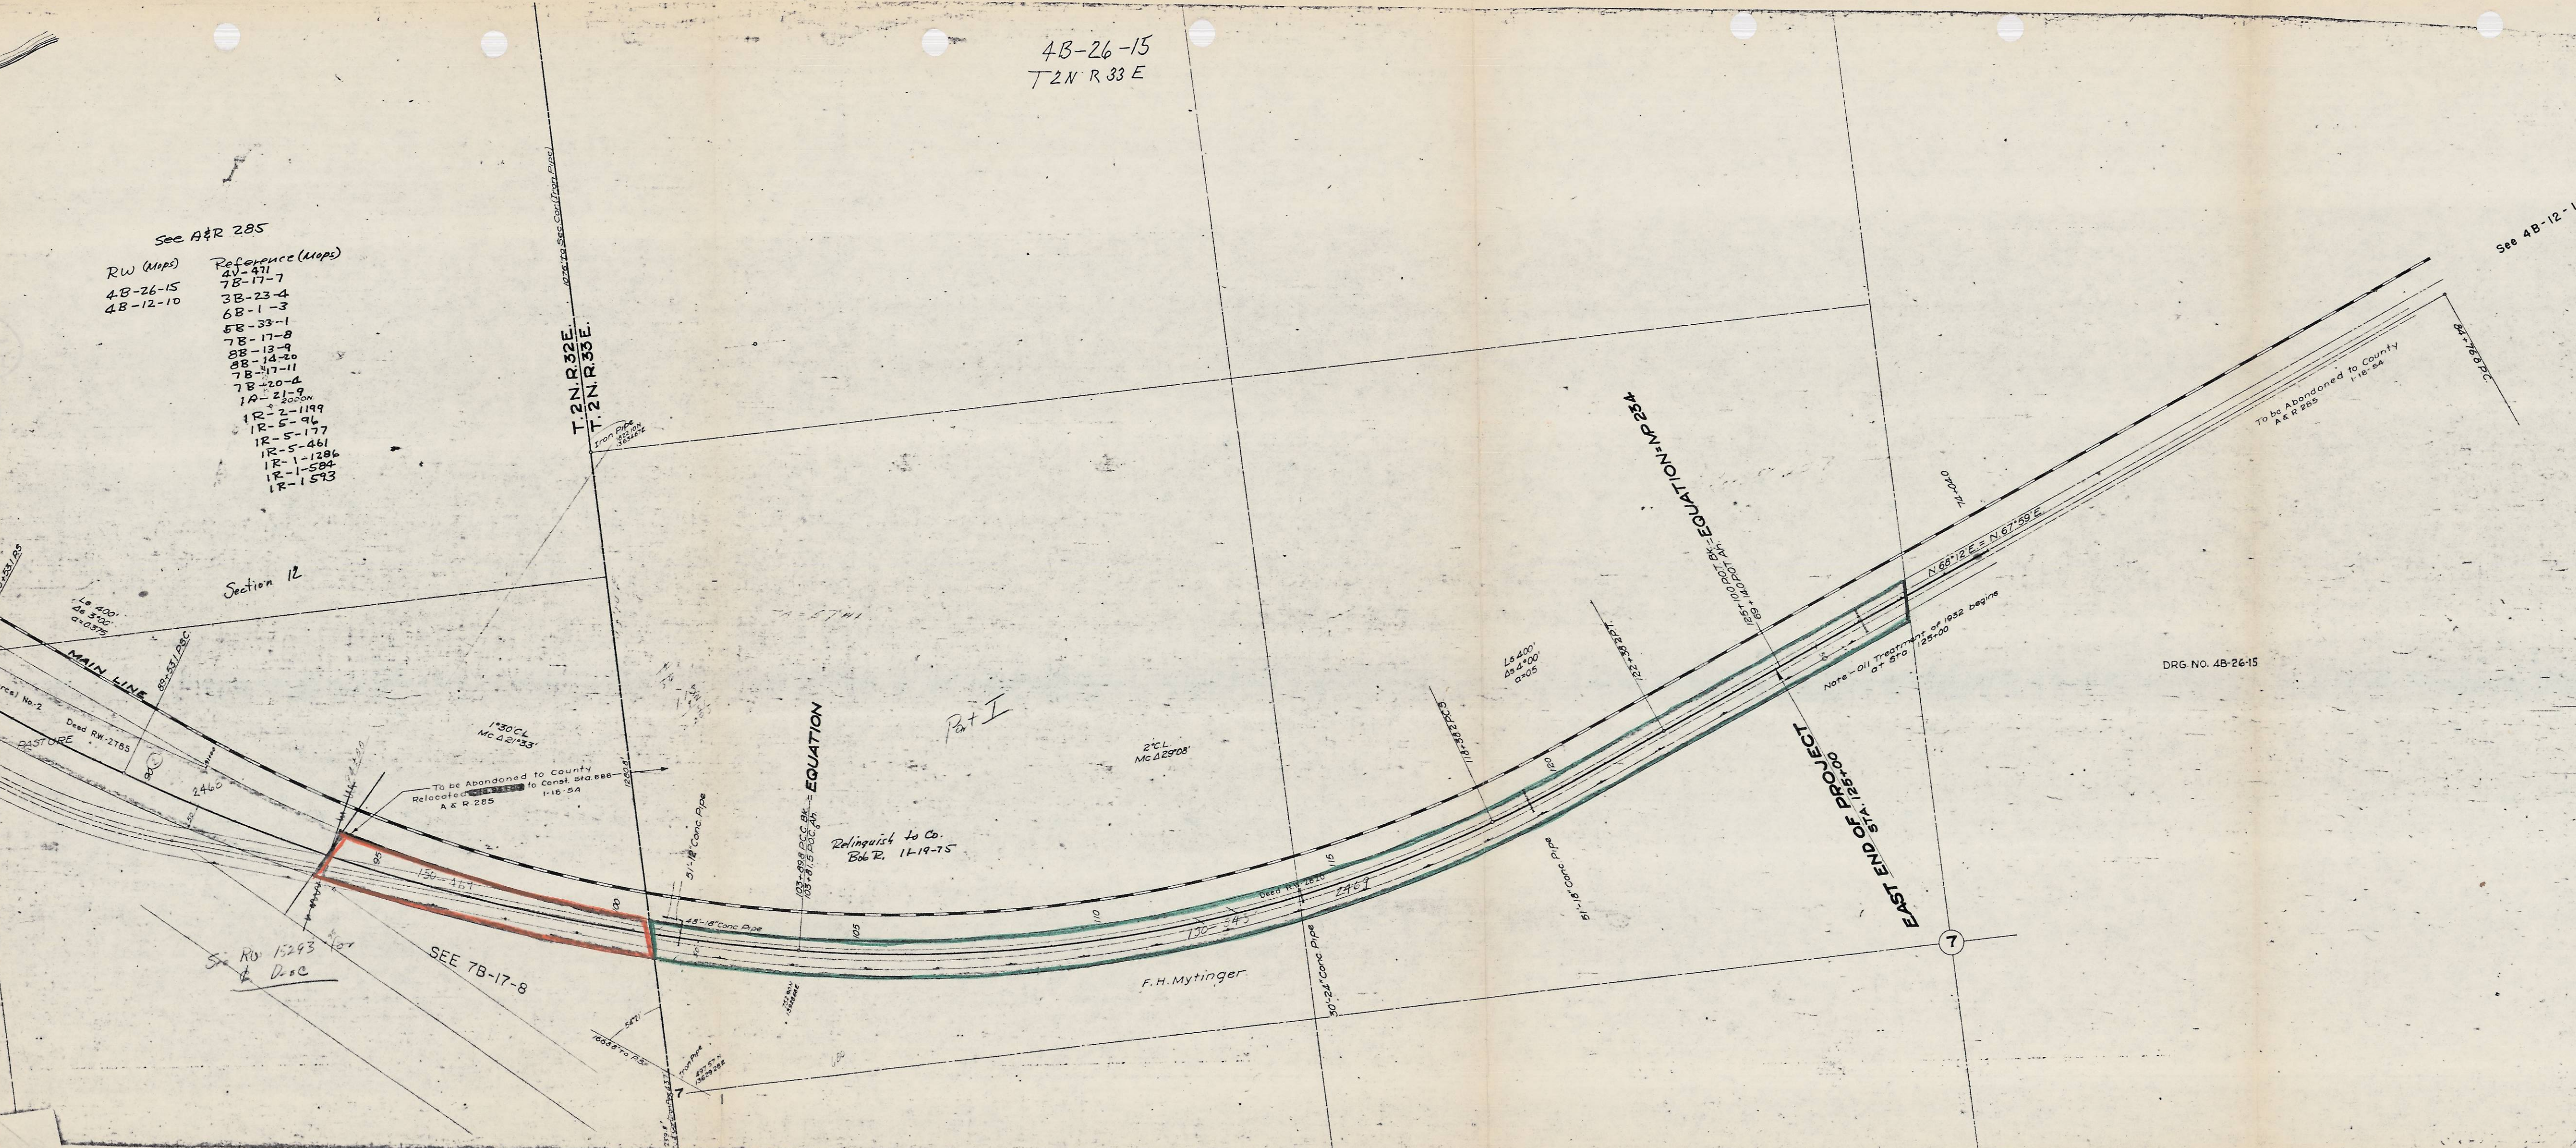

DRG. NO. 4B-26-15

See 4B-12-10

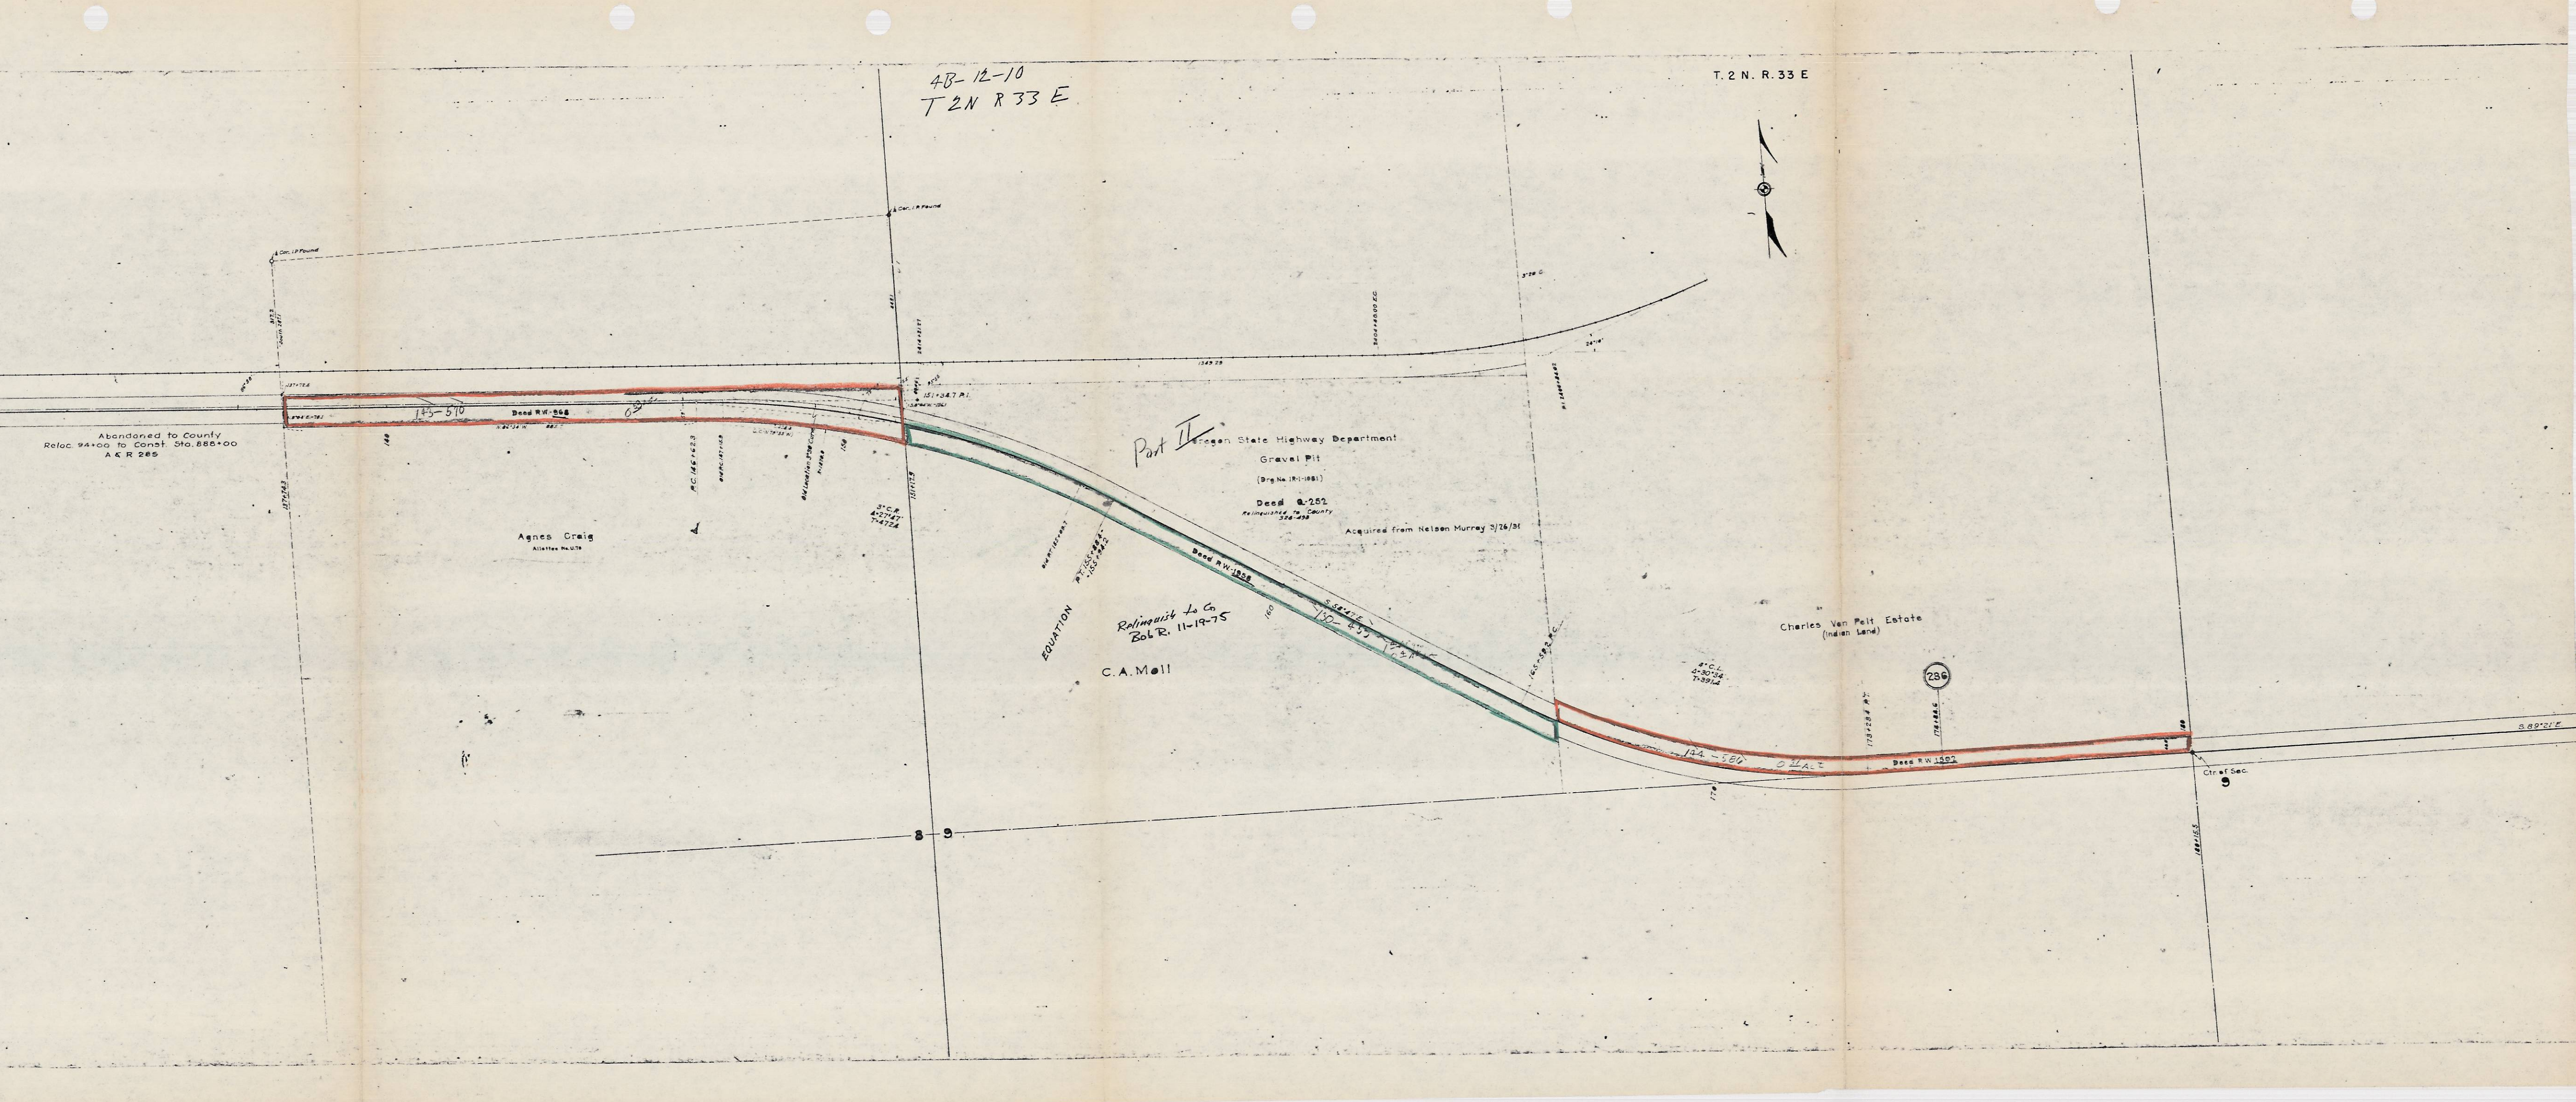

Part II

Relinquish Co.
Bol R. 11-19-75

C.A. Moll

Charles Van Pelt Estate
(Indian Land)

285