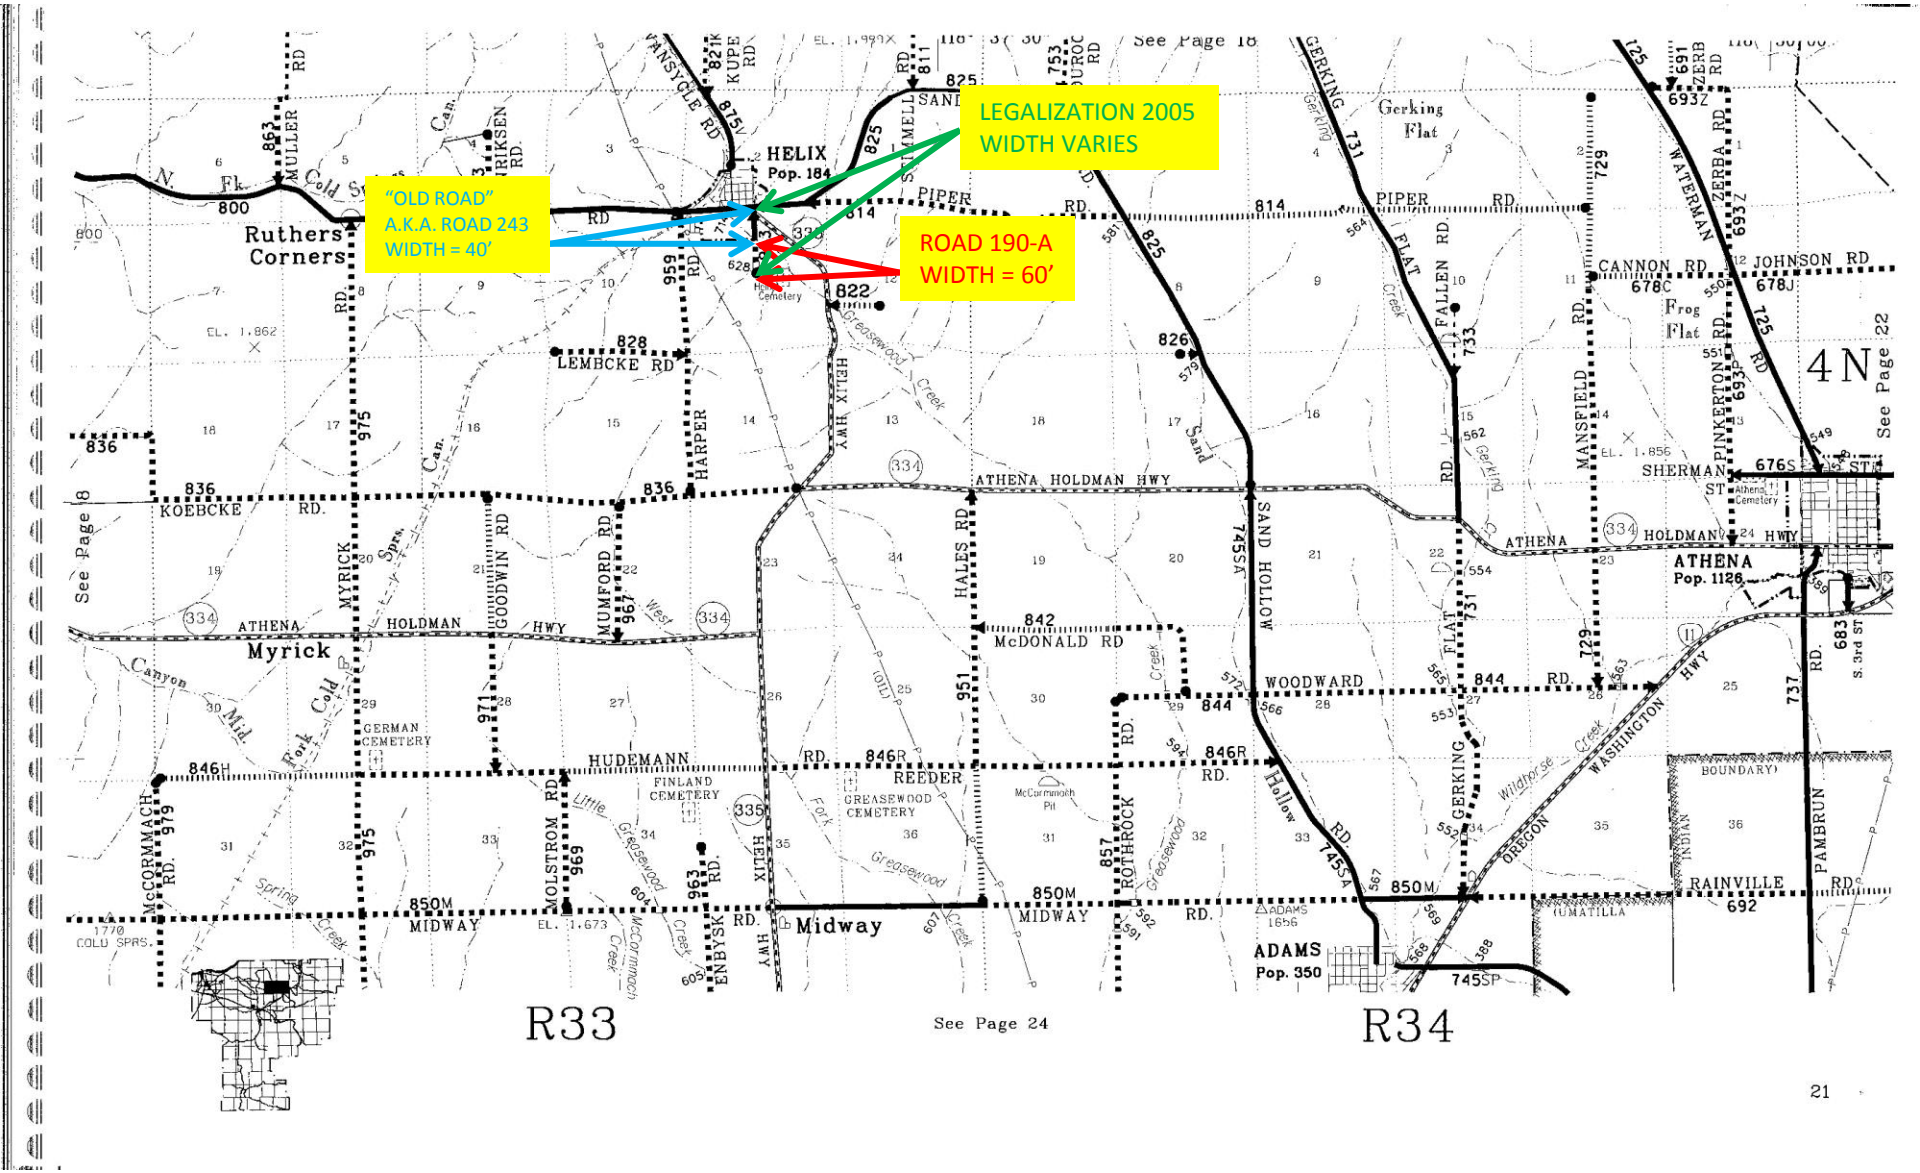
LEGALIZATION 2005
WIDTH VARIES
"OLD ROAD"
A.K.A. ROAD 243
WIDTH = 40'
ROAD 190-A
WIDTH = 60'
HELIX
Pop. 184
Ruthers Corners
Gerking Flat
Frog Flat
ATHENA
Pop. 1126
ADAMS
Pop. 350
Myrick
Midway
LEMBCKE RD
ATHENA HOLDMAN HWY
McDONALD RD
WOODWARD RD
HUDEMANN RD
REEDER RD
PIPER RD
CANNON RD
JOHNSON RD
SHERMAN ST
KOEBCKE RD
SAND HOLLOW RD
GERKING FLAT RD
FALLEN RD
MANSFIELD RD
PINKERTON RD
WATERMAN RD
ZERBA RD
HARPER RD
HALES RD
MUMFORD RD
GOODWIN RD
MYRICK RD
MOLSTROM RD
ROTHROCK RD
McCORMMACH RD
ENBYSK RD
PAMBRUN RD
WASHINGTON
OREGON
HELIX HWY
Greasewood Creek
Wildhorse Creek
Mid. Fork Cold Spr. Canyon
Spring Creek
McCormmach Creek
Little Greasewood Creek
Fork Greasewood Creek
Sand Creek
GERMAN CEMETERY
FINLAND CEMETERY
GREASEWOOD CEMETERY
Athena Cemetery
McCormmach Pit
BOUNDARY
INDIAN
(UMATILLA)
RAINVILLE
692
4N
See Page 22
See Page 18
See Page 24
See Page 8
R33
R34
21