


Road 101

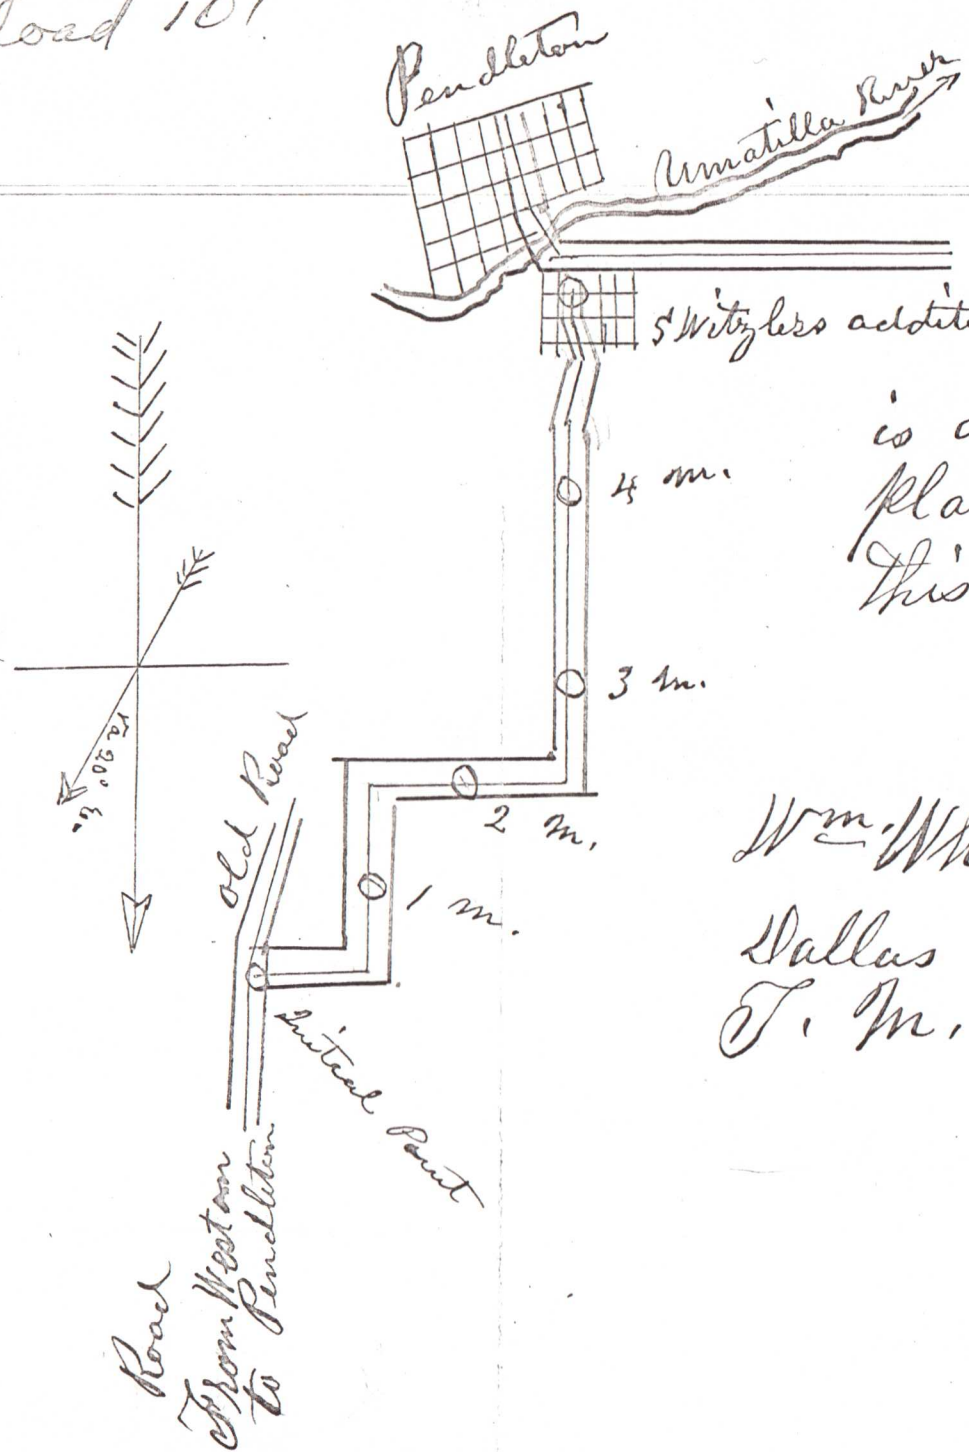

 I hereby certify that the within
 is a true and correct return and
 plat of the within named Road
 this 21 day of April 1881

J. H. Raley County Surveyor
 By A. L. Coffey, Dep't.
 Wm. White Atman }
 Dallas Price and }
 J. M. Coffey } Chairmen