

See Page 11

BY DEED
WIDTH = 50'

SEE OSHD R/W MAP

BY DEED
WIDTH = 40'

LEGALIZATION 1997
WIDTH = 60'

ROAD 371
WIDTH = 60'


ROAD 371
WIDTH = 60'

LEGALIZATION 2002
WIDTH VARIES

R31

R32

See Page 31

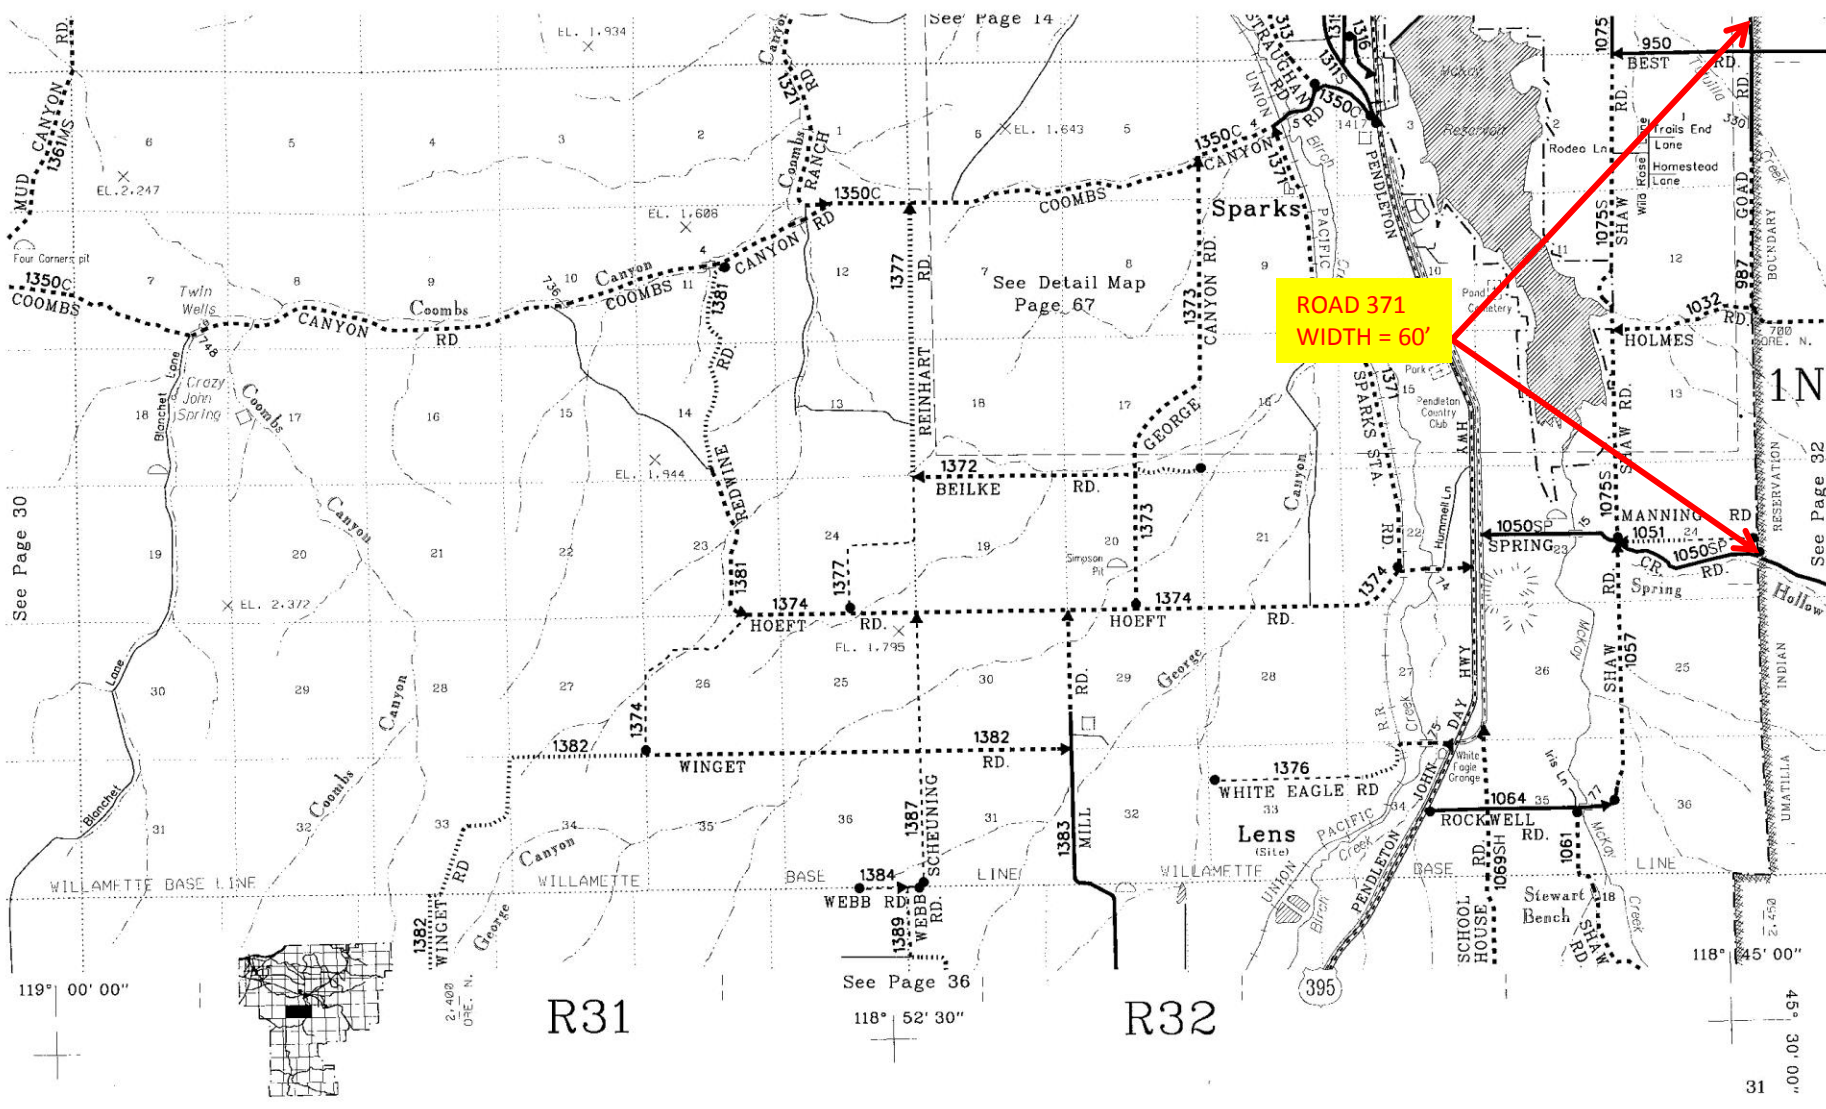

**ROAD 371
WIDTH = 60'**

See Page 30

See Page 14

See Detail Map
Page 67

See Page 32

See Page 36

119° 00' 00"

R31

R32

118° 52' 30"

118° 45' 00"

45° 30' 00"

31

