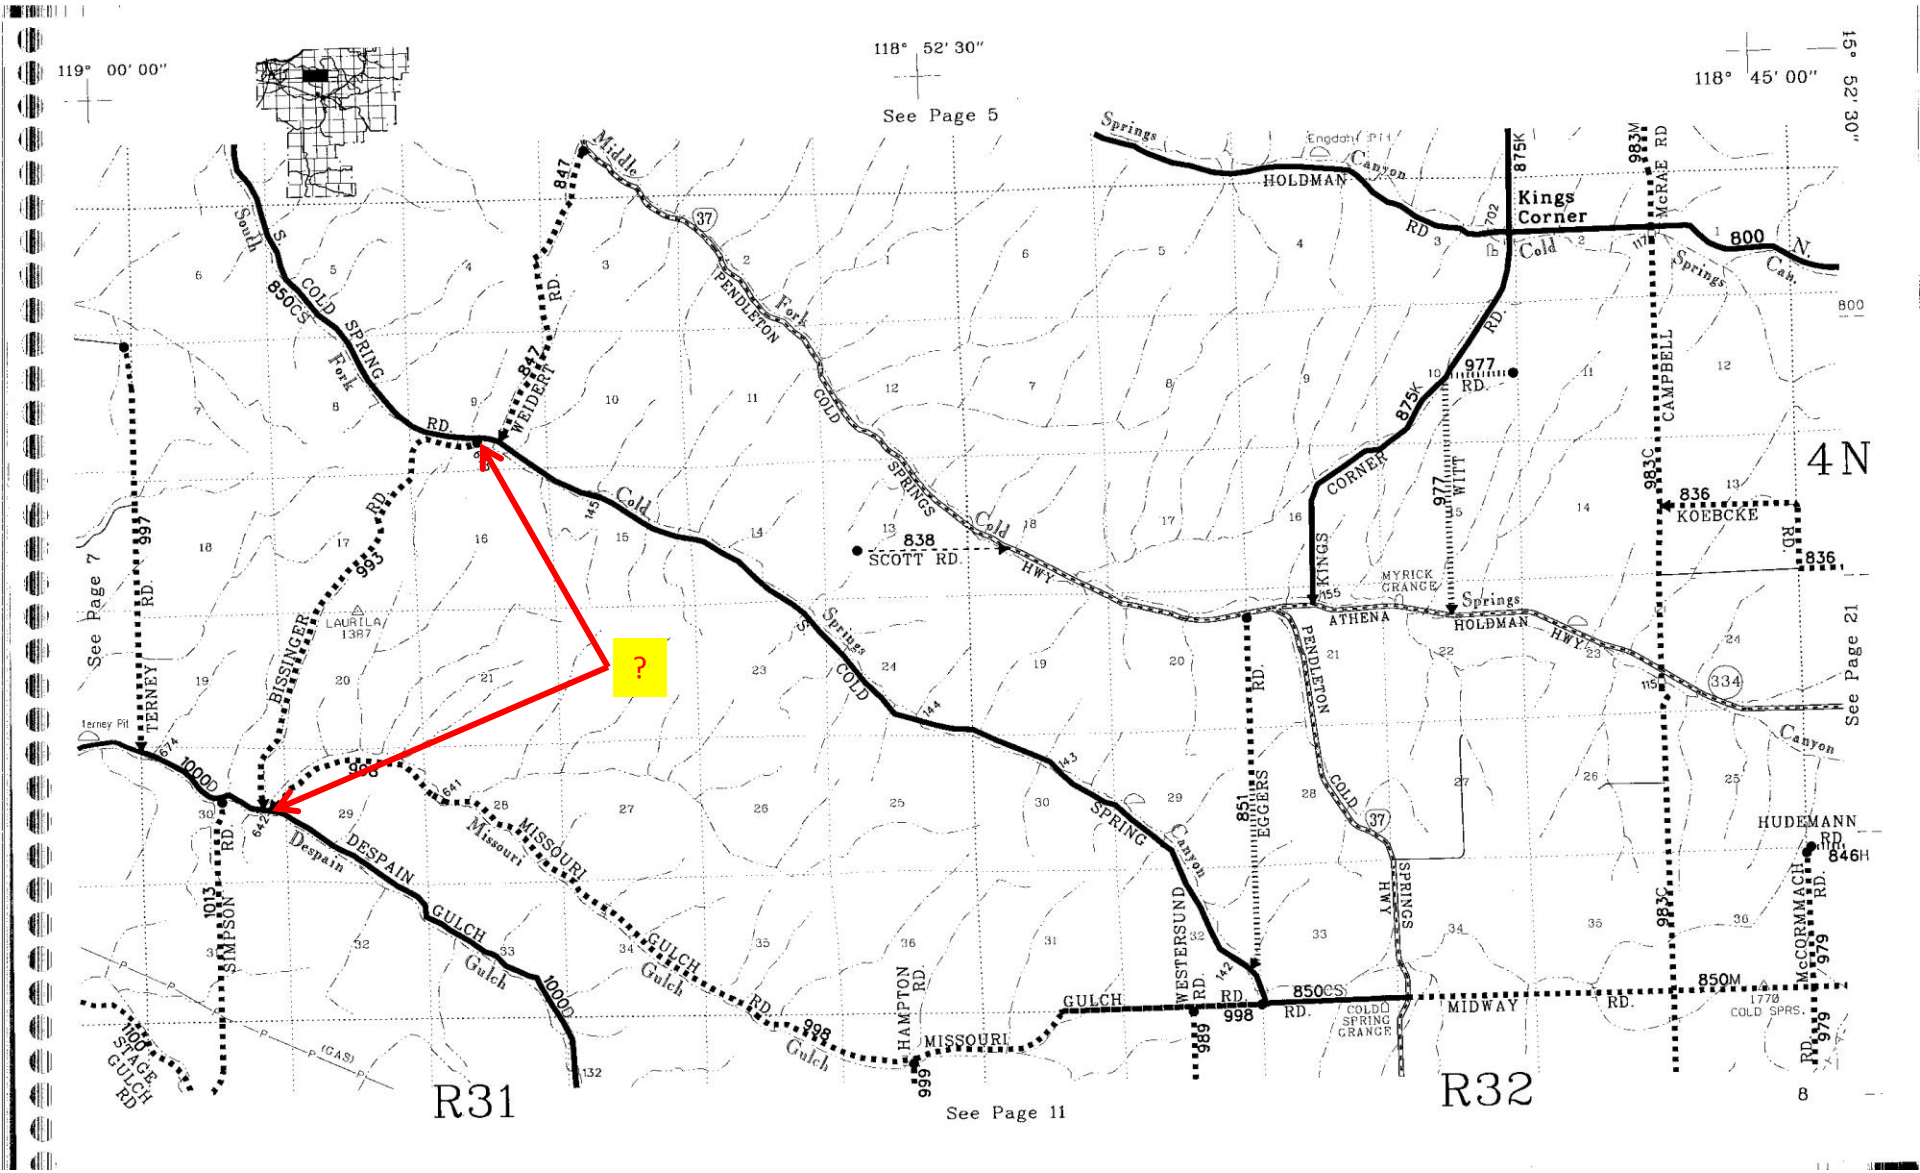
119° 00' 00"
118° 52' 30"
118° 45' 00"
15° 52' 30"
See Page 5
See Page 7
See Page 21
See Page 11
4N
R31
R32
Kings Corner
HOLDMAN
Springs
Canyon
Cold
South Fork
COLD SPRING
PENDLETON
MIDDLE
WEIDERT RD.
SCOTT RD.
COLD SPRINGS HWY
KINGS CORNER
WITT RD.
CAMPBELL
McRAE RD.
KOEBCKE
MYRICK GRANGE
ATHENA
PENDLETON RD.
HOLDMAN HWY
TERNEY RD.
BISSINGER
LAURILA
1387
Terney Pit
DESPAIN
Despain
GULCH
Gulch
MISSOURI
Missouri
SIMPSON
HAMPTON RD.
WESTERSUND RD.
EGGERS
COLD SPRINGS HWY
COLD SPRING GRANGE
MIDWAY
HUDEMANN RD.
McCORMMACH RD.
COLD SPRS.
SPRING
SPRINGS
?