


**ROAD 645
WIDTH = 40'**

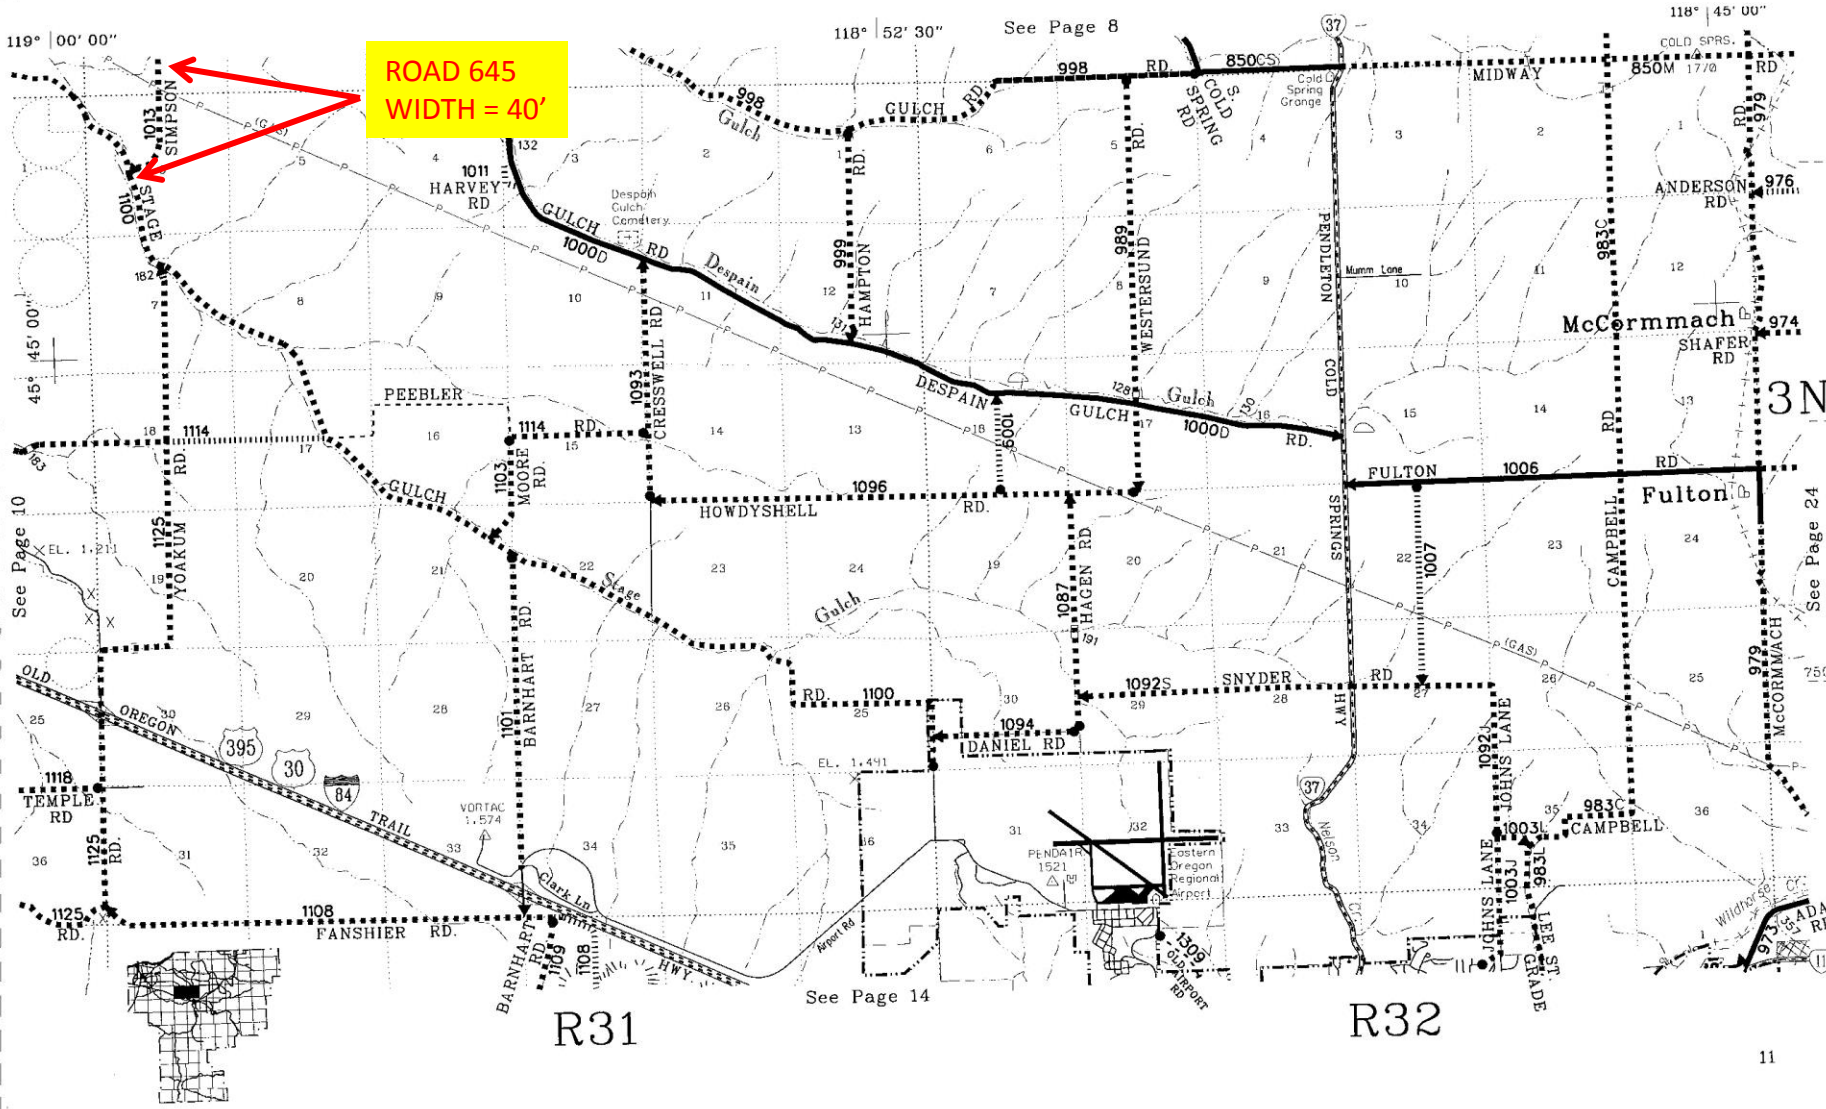

R31

R32