

ROAD 640
WIDTH = 40'

?

118° 45' 00"

R33

See Page 37

118° 37' 30"

R34

118° 30' 00"


32

See Page 33

1N



?

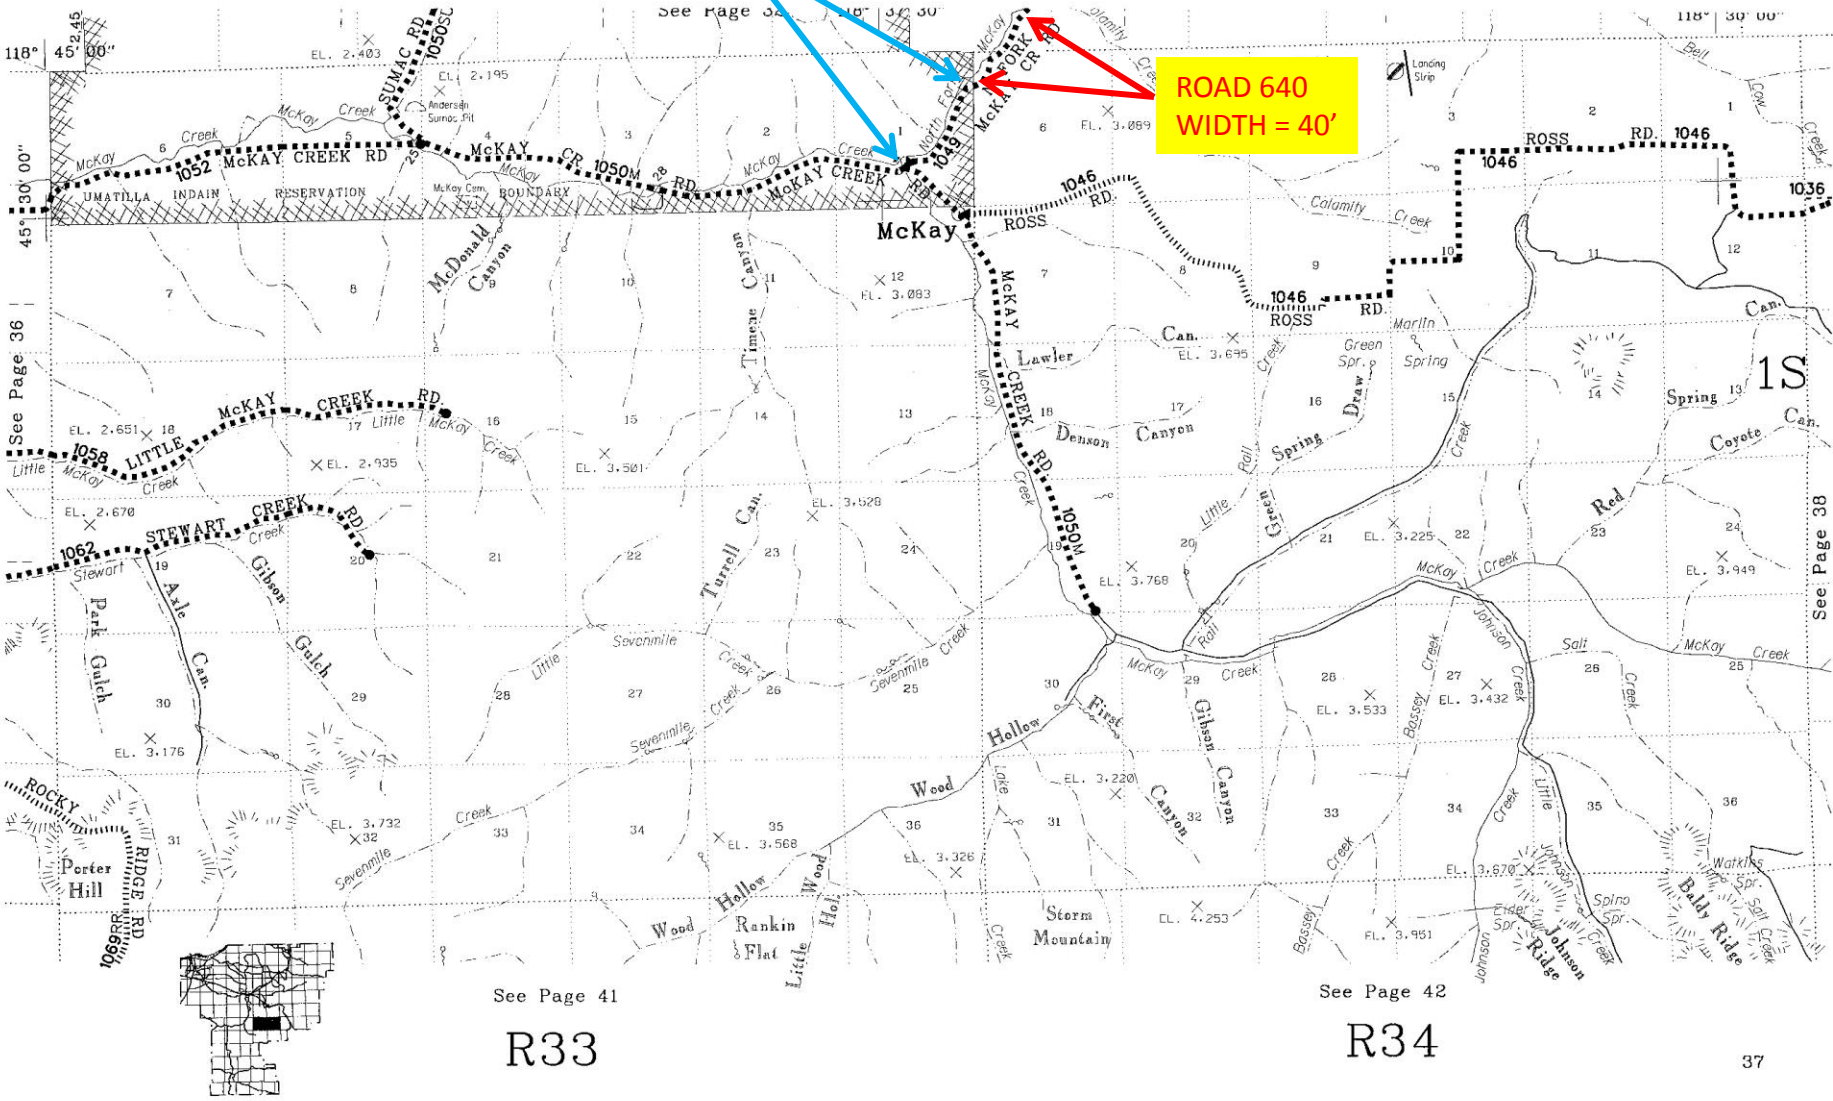

ROAD 640
WIDTH = 40'

See Page 41

R33

See Page 42

R34