


**ROAD 382
WIDTH = 60'**

**ROAD 641
WIDTH = 60'**

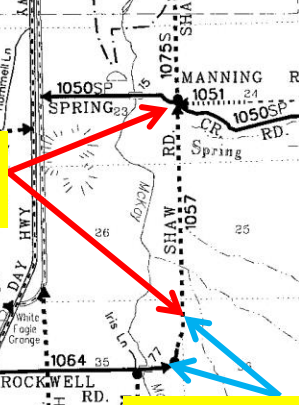

See Page 30

See Page 14

See Detail Map
Page 67

See Page 32

See Page 36

119° 00' 00"

R31

R32

118° 45' 00"

31

45° 30' 00"