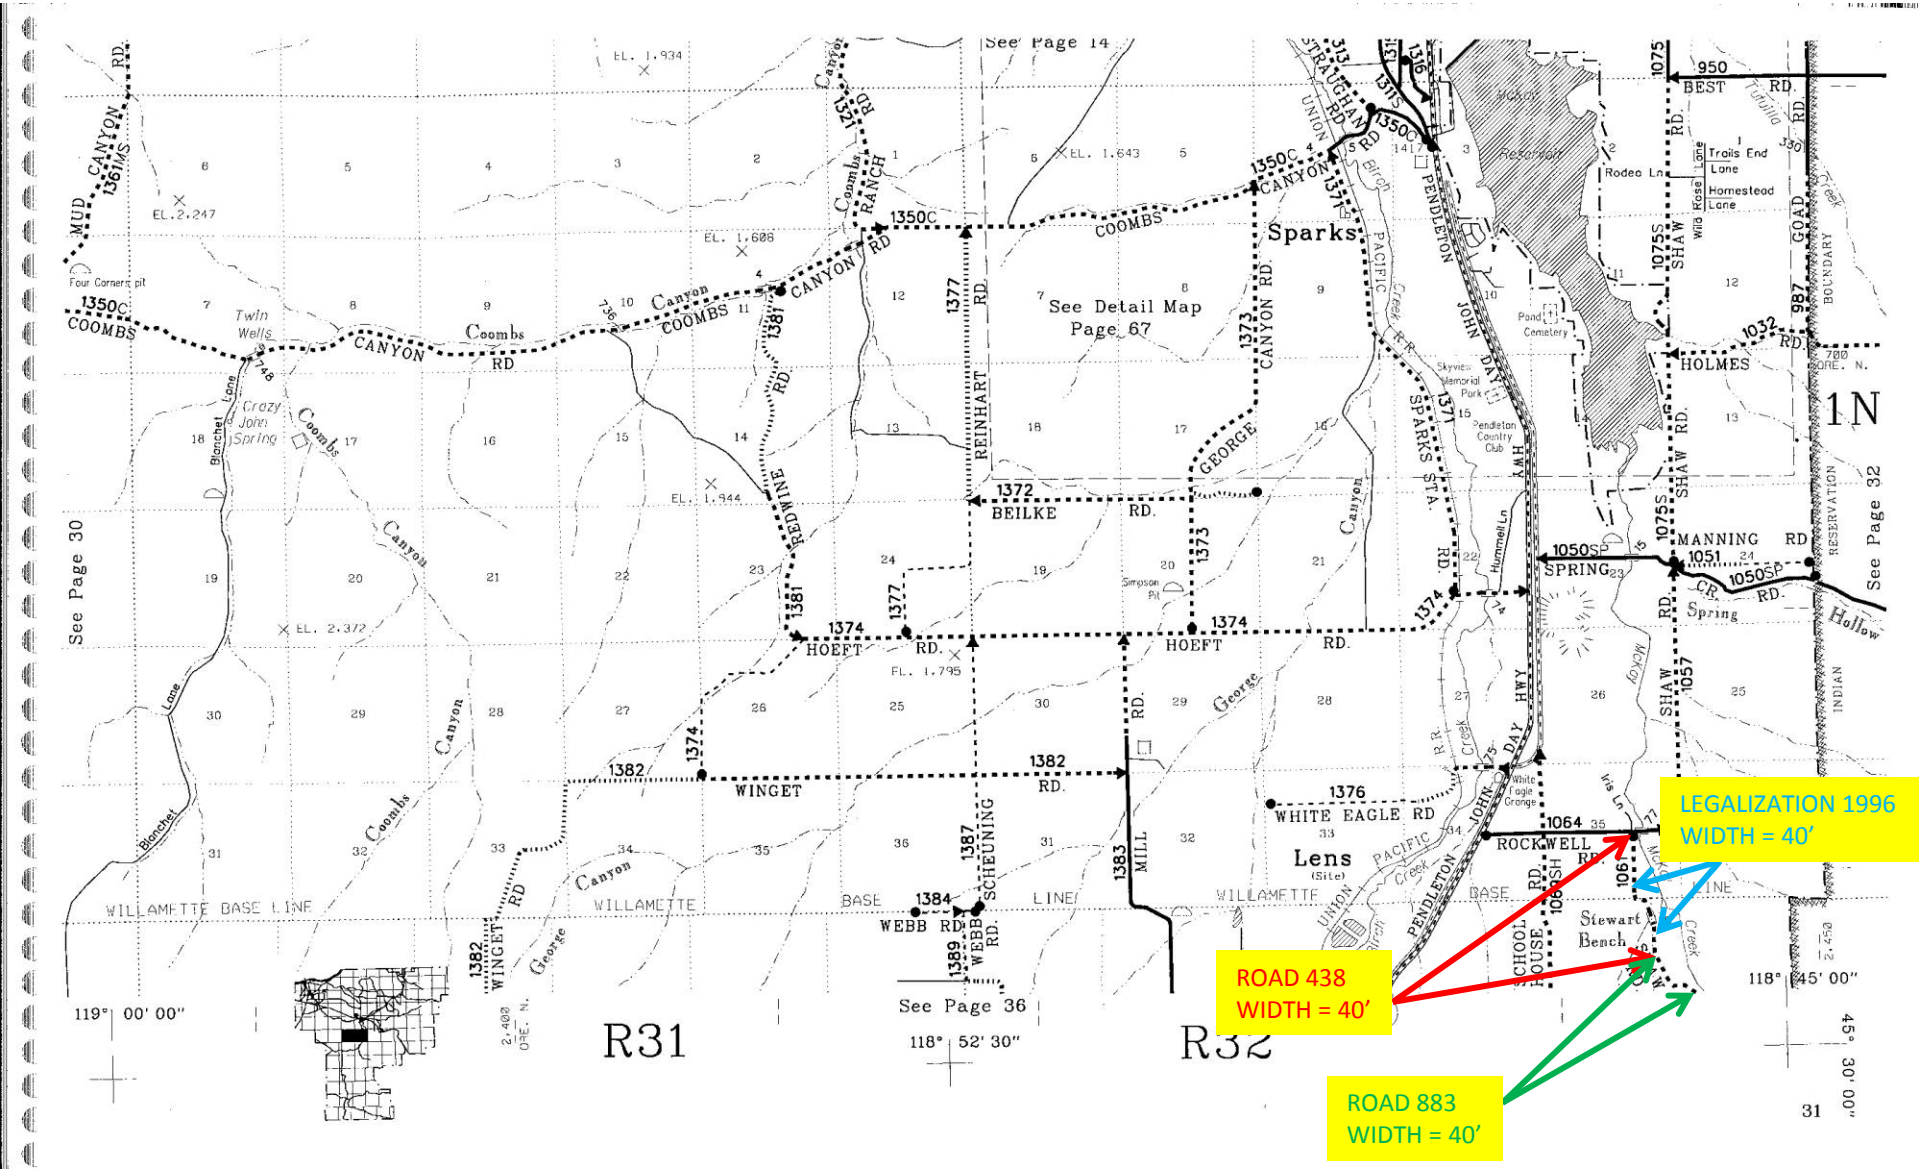
LEGALIZATION 1996
WIDTH = 40'
ROAD 438
WIDTH = 40'
ROAD 883
WIDTH = 40'
See Page 14
See Page 30
See Page 32
See Page 36
See Detail Map
Page 67
Sparks
Lens
(Site)
Stewart
Bench
R31
R32
1N
119° 00' 00"
118° 52' 30"
118° 45' 00"
45° 30' 00"
WILLAMETTE BASE LINE
COOMBS
CANYON
RD
BEILKE
HOEFT
WINGET
WEBB
WHITE EAGLE RD
ROCKWELL
SPRING
MANNING
HOLMES
BEST
GEORGE
REINHART
REDWINE
SCHEUNING
MILL
PENDLETON
JOHN DAY
SPARKS STA.
SHAW
GOAD
Twin Wells
Crazy John Spring
Four Corners pit
Simpson Pit
Pendleton Country Club
Skyview Memorial Park
Pond Cemetery
Trails End Lane
Homestead Lane
Rodeo Ln
Hummell Ln
White Eagle Grange
Iris Ln
Blanchet Lane
Coombs Canyon
George Canyon
Mckay Creek
Spring Hollow
Tutuilla Creek
Birch Creek
Wild Rose Lane
Pacific R.R.
Union Pacific
Indian Reservation Boundary
Ore. N.
31

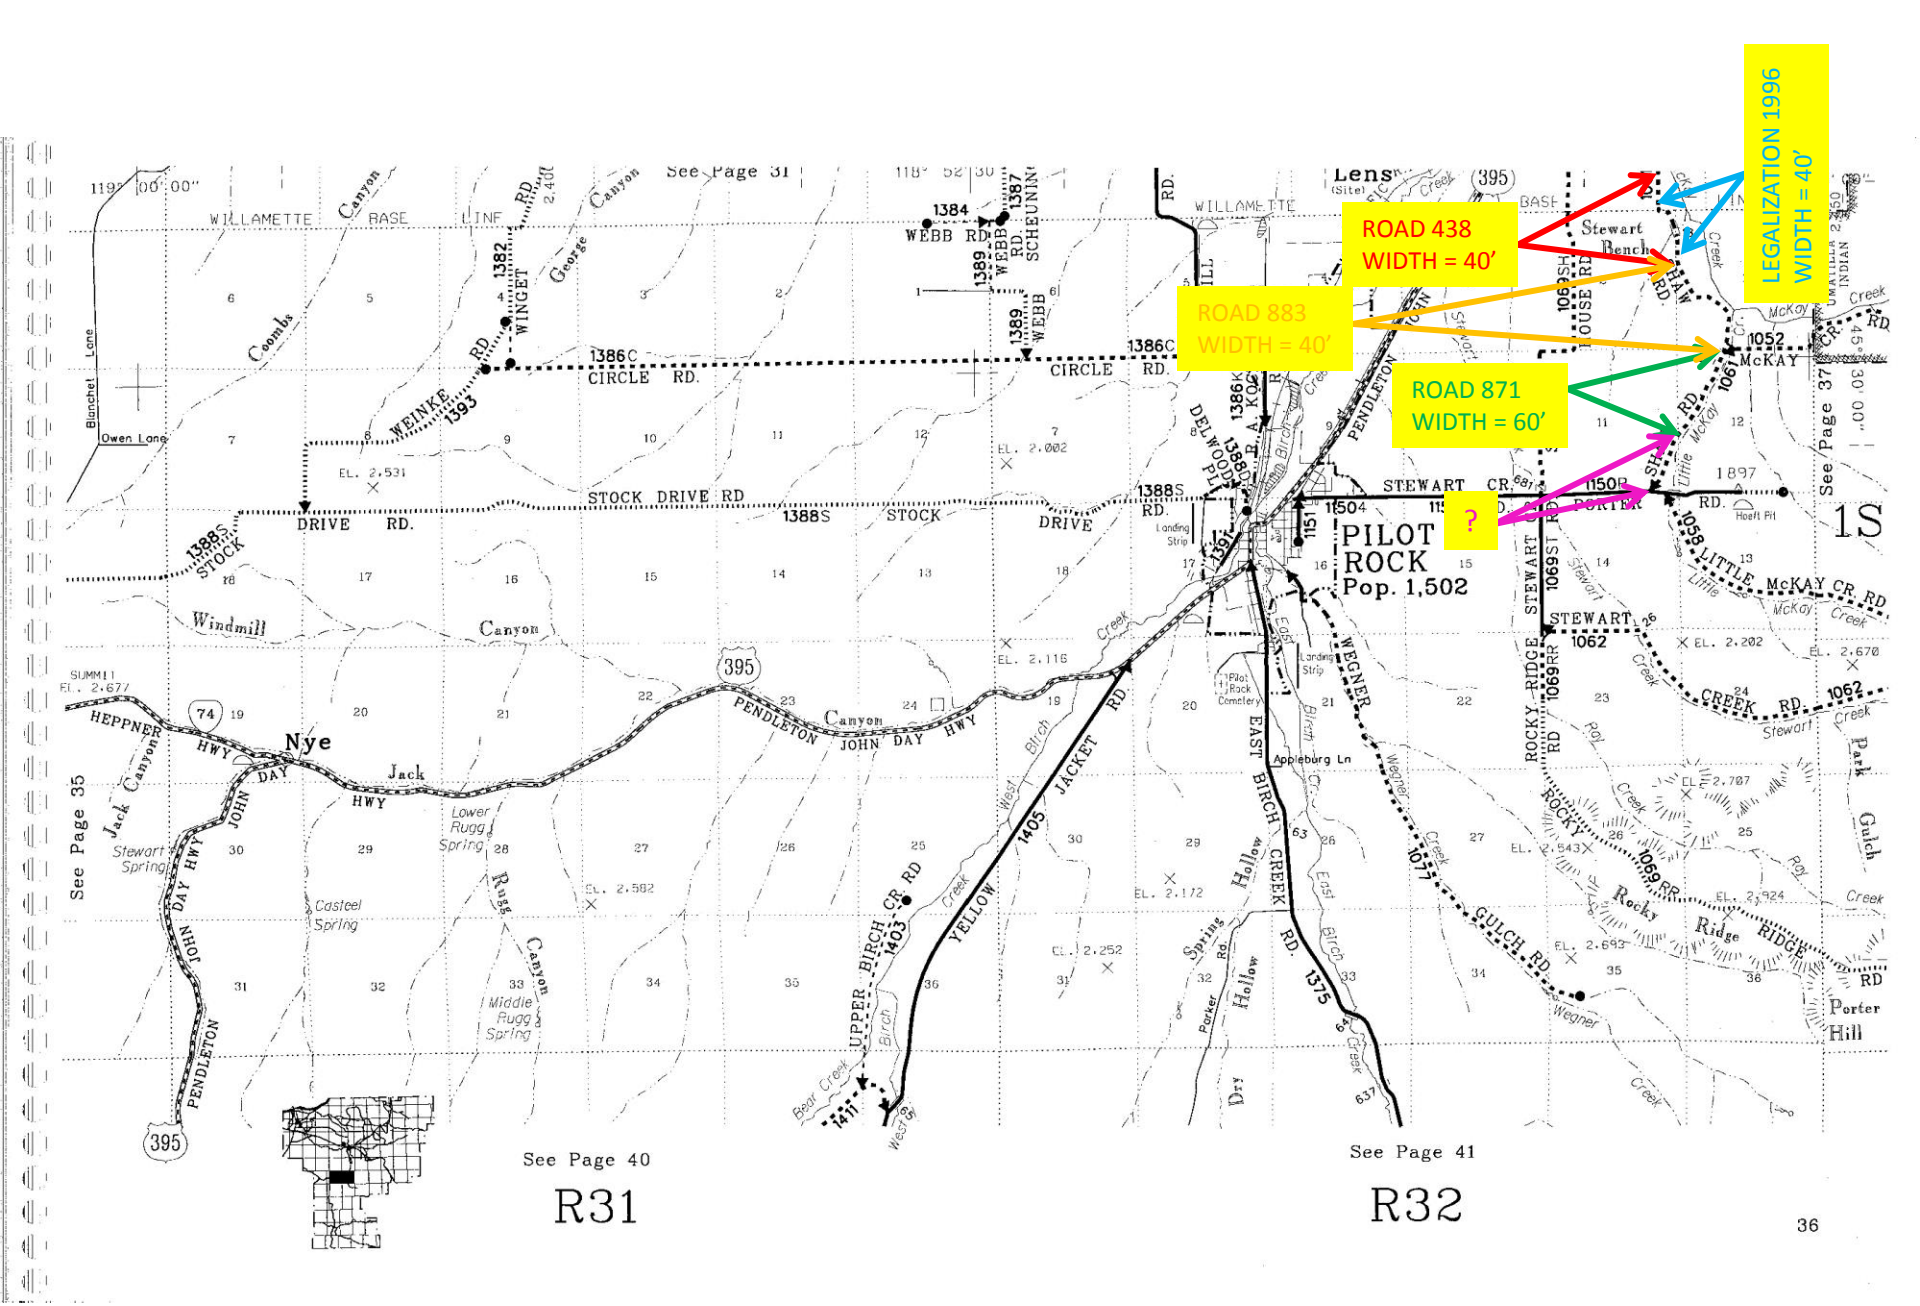

LEGALIZATION 1996
WIDTH = 40'
ROAD 438
WIDTH = 40'
ROAD 883
WIDTH = 40'
ROAD 871
WIDTH = 60'
?
PILOT
ROCK
Pop. 1,502
See Page 31
See Page 35
See Page 37
See Page 40
See Page 41
R31
R32
1S