


Road 101

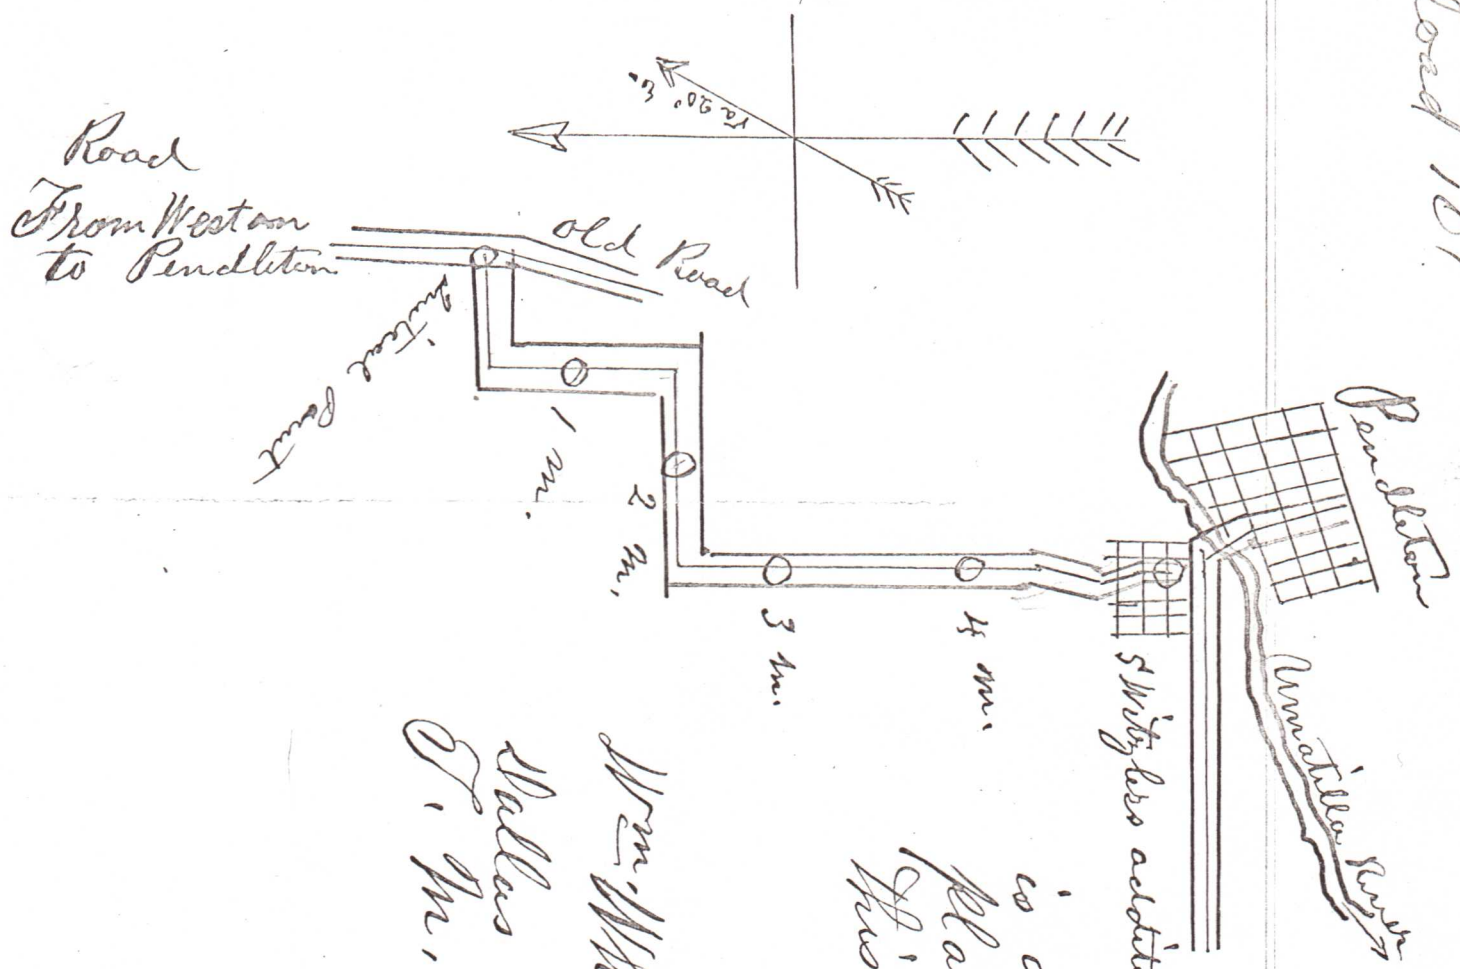

Road from Pendleton to Amatilla

Shelby testified that the within
 is a true and correct return and
 plat of the within named Road
 this 21 day of April 1881

J. H. Foley County Surveyor
 by A. T. Coffey, Deft.

Wm. White Atman
 Dallas Price and
 T. M. Coffey } Chaimmen