


109

73 W R 31 East

W

E

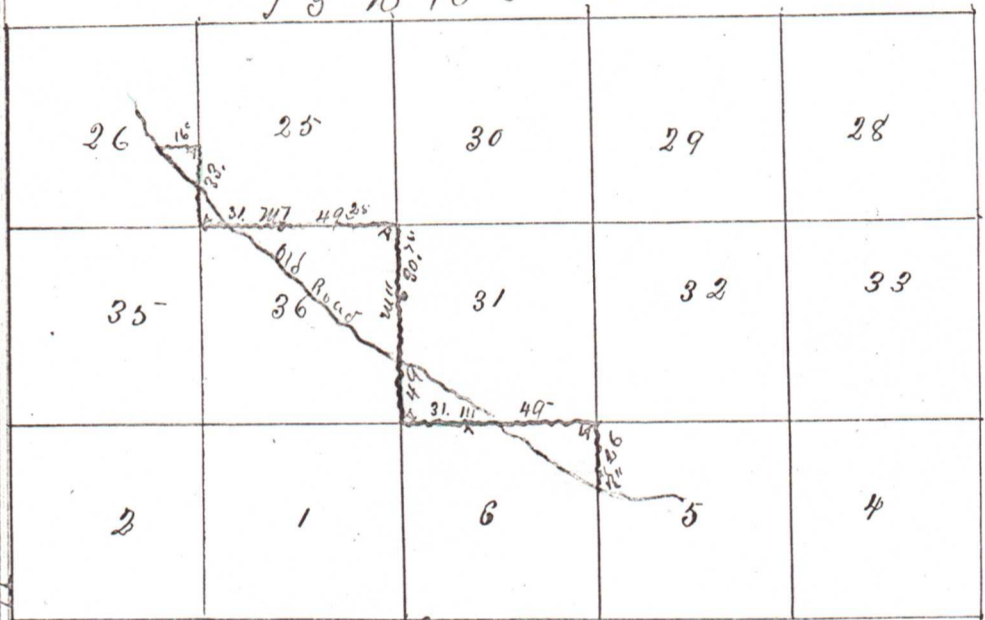

S