

ROAD 82  
WIDTH = 60'

ROAD 82  
1955 REALIGNMENT  
UNIT 1  
WIDTH = 60'

BY DEED  
WIDTH = 60'

ROAD 82  
WIDTH = 60'

ROAD 82  
WIDTH = 60'

R29

R30

10

See Page 11

See Page 13


See Page 9

See Detail Map Page 68

See Detail Map Page 58

See page 7



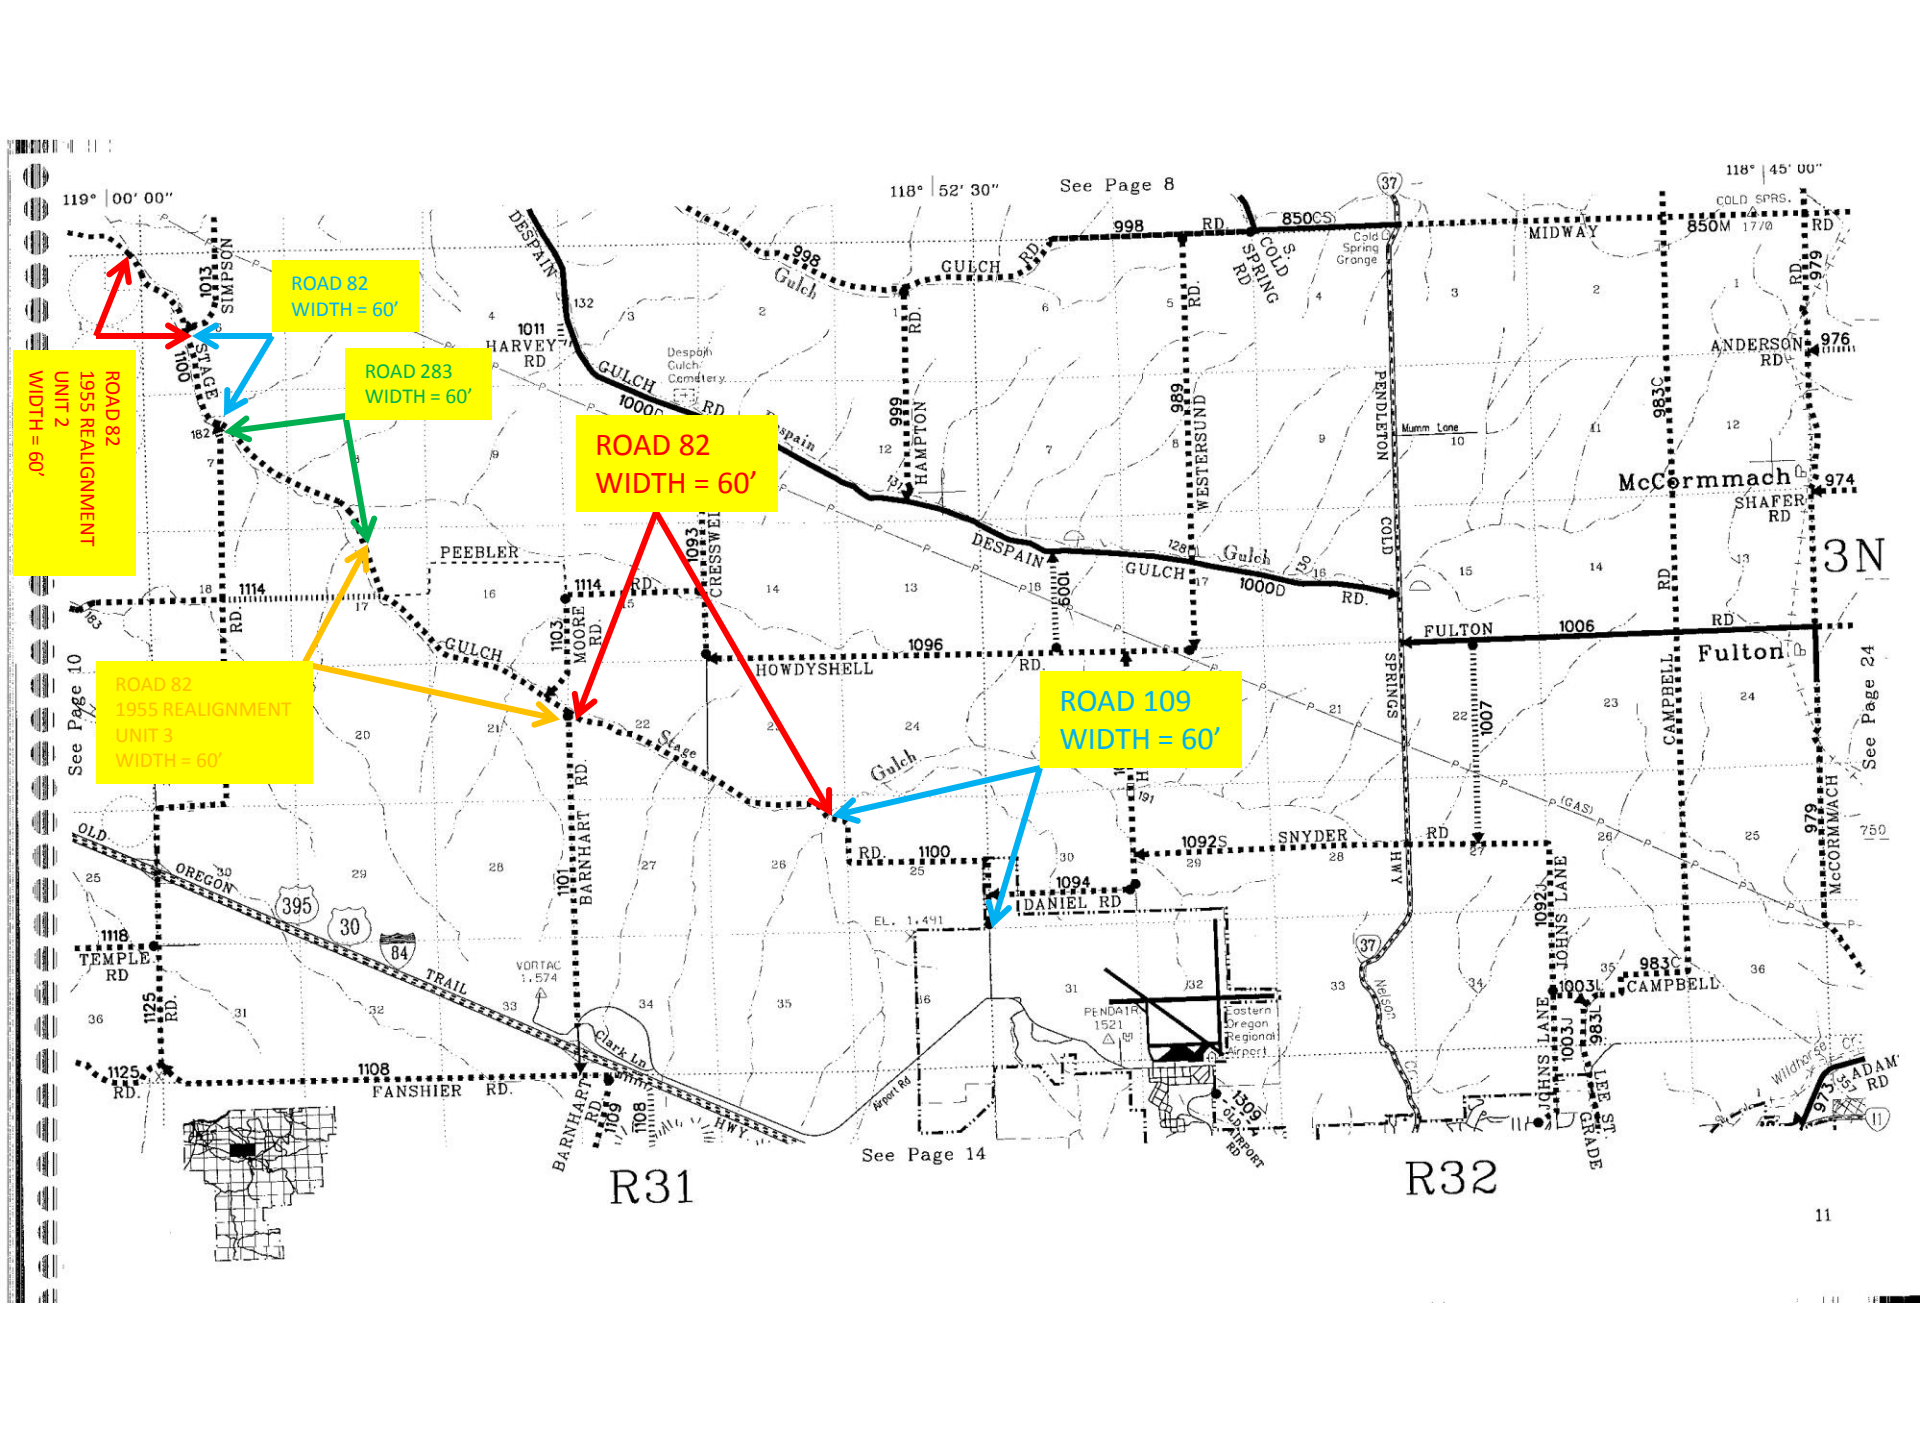

ROAD 82  
1955 REALIGNMENT  
UNIT 2  
WIDTH = 60'

ROAD 82  
WIDTH = 60'

ROAD 283  
WIDTH = 60'

ROAD 82  
WIDTH = 60'

ROAD 82  
1955 REALIGNMENT  
UNIT 3  
WIDTH = 60'

ROAD 109  
WIDTH = 60'

R31

R32